Walk-Thru

DEPT. OF INSPECTIONS, LICENSES AND PERMITS
3430 COURT HOUSE DRIVE
ELLICOTT CITY, MD 21043
PERMITS (410) 313-2455
INSPECTIONS (410) 313-1810
AUTOMATED INFORMATION (410) 313-3800

HOWARD COUNTY PERMIT APPLICATION

PERMIT NUMBER

Building Address _____

Suite/Apt. #: _____ SDP/WP/Petition #: _____

Census Tract _____ Subdivision _____

Section _____ Area _____ Lot 6

Tax Map 15 Parcel 116 Grid 13

Zoning _____ Map Coordinates _____ Lot Size 3.0 Ac

Property Owner's Name Anton Dvorak
Address 13920 Old Rover Mill Rd.
City West Friendship State Md Zip Code 21719
Phone 301 649 0570 Phone _____
Applicant's Name & Mailing Address, (if other than stated herein):

Phone Fax

Existing Use Single Family
Proposed Use Single Family with Deck
Estimated Construction Cost $ 22,000

Description of Work To build a deck on Back of house ~~w~~ 45' wide by 24' Deep with steps

Occupant or Tenant _____

Contact Name Anton Dvorak

Address 13920 old Roverwill Rd.

City West Friendship State Md Zip Code 21719

Phone Fax

Contractor Company GEM Contracting LLC
Contact Person Glenn Murphy
Address 1940 Long Corner Rd.
City Mount Airy State Md Zip Code 21771
License No. 71206
Phone 301 829 8062 Fax 301 829 8063

Engineer or Architect Company _____

Contact Person _____

Address _____

City _____ State _____ Zip Code _____

Phone Fax

BUILDING DESCRIPTION – *COMMERCIAL*

Building Characteristics

Height:

No. of stories:

Gross area, sq. ft. per floor:

Use group:

Construction type:
____ Reinforced Concrete
____ Structural Steel
____ Masonry
____ Wood Frame

____ State Certified Modular

Utilities

Water Supply:
____ Public
____ Private
Sewage Disposal:
____ Public
____ Private

Electric Yes ☐ No ☐
Gas Yes ☐ No ☐

Heating System:
Electric ☐ Oil ☐
Natural Gas ☐
Propane Gas ☐

Sprinkler system: N/A ☐
____ Full
____ Partial
____ Other Suppression
____ # of Heads

BUILDING DESCRIPTION – *RESIDENTIAL*

Building Characteristics

SF Dwelling ☐ SF Townhouse ☐
Depth Width
1st floor:
2nd floor:
Basement:

Finished Basement ☐ Unfinished Basement ☐
Crawl space ☐ Slab on Grade ☐
No. of Bedrooms _____

Multi-family dwellings:
No. of efficiency units: ____
No. of 1 BR units: _____
No. of 2 BR units: _____
No. of 3 BR units: _____

Other Structure: Deck
Dimensions: 24'x 45'
Footings: _____
Roof Height: _____

____ State Certified Modular
____ Manufactured Home

Utilities

Water Supply:
__✓__ Public
__✓__ Private
Sewage Disposal:
__✓__ Public
__✓__ Private

Electric Yes ☐ No ☐
Gas Yes ☐ No ☐

Heating System:
Electric ☐ Oil ☐
Natural Gas ☐
Propane Gas ☐

Sprinkler system: N/A ☐
____ NFPA #13D
____ NFPA #13R
____ Other:

THE UNDERSIGNED HEREBY CERTIFIES AND AGREES AS FOLLOWS: (1) THAT HE/SHE IS AUTHORIZED TO MAKE THIS APPLICATION; (2) THAT THE INFORMATION IS CORRECT; (3) THAT HE/SHE WILL COMPLY WITH ALL REGULATIONS OF HOWARD COUNTY WHICH ARE APPLICABLE THERETO; (4) THAT HE/SHE WILL PERFORM NO WORK ON THE ABOVE REFERENCED PROPERTY NOT SPECIFICALLY DESCRIBED IN THIS APPLICATION; (5) THAT HE/SHE GRANTS COUNTY OFFICIALS THE RIGHT TO ENTER ONTO THIS PROPERTY FOR THE PURPOSE OF INSPECTING THE WORK PERMITTED AND POSTING NOTICES.

Applicant's Signature — Glenn Murphy, Print Name

Owner Gem Contracting LLC, Title/Company — 7-29-09, Date

Checks payable to: **DIRECTOR OF FINANCE OF HOWARD COUNTY**
PLEASE WRITE NEATLY AND LEGIBLY.
- FOR OFFICE USE ONLY -

AGENCY | DATE | SIGNATURE/APPROVAL | DPZ SETBACK INFORMATION | PROPERTY ID #

Land Development - DPZ
Street Ways
Building Official
Dev. Engineering - DPZ
Zoning
Fire Protection
Sediment Control approval required prior to issuance
YES NO
Front
Rear
Side
Side
Minimum setbacks met
YES NO
Variance or Permit required
YES NO
Historic District
YES NO
Lot Coverage for New Town Zone
SDP/Preliminary approval date
Accepted by

Billing fee $
Permit fee $
Excise tax $
Add'l fee $
TOTAL FEES
Subtotal paid $
Balance due $
Check #
Validation #

CONTINGENCY CONSTRUCTION START
ONE STOP SHOP

Distribution of Copies: White: Building Official Green: LDD/DPZ Yellow: DED/DPZ Pink: Health Gold: SHA
T:\forms\buildingperm application

REV 10/28/04

7

~~APPROVED~~

WALK-THRU BUILDING PERMIT

BP# _____ A# _____

APP. SAN DBernard DATE: 1-29-09

DESC. OF WORK: * Deck

24'

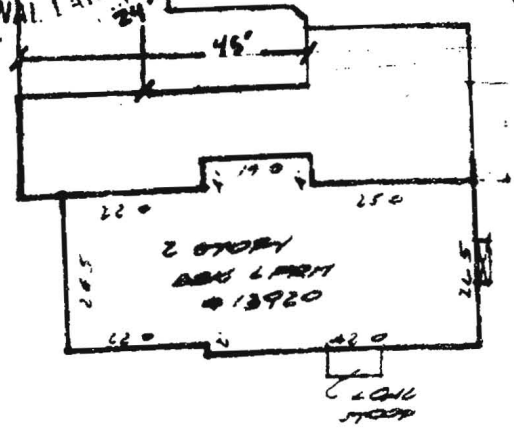

DETAIL : 1" = 30'

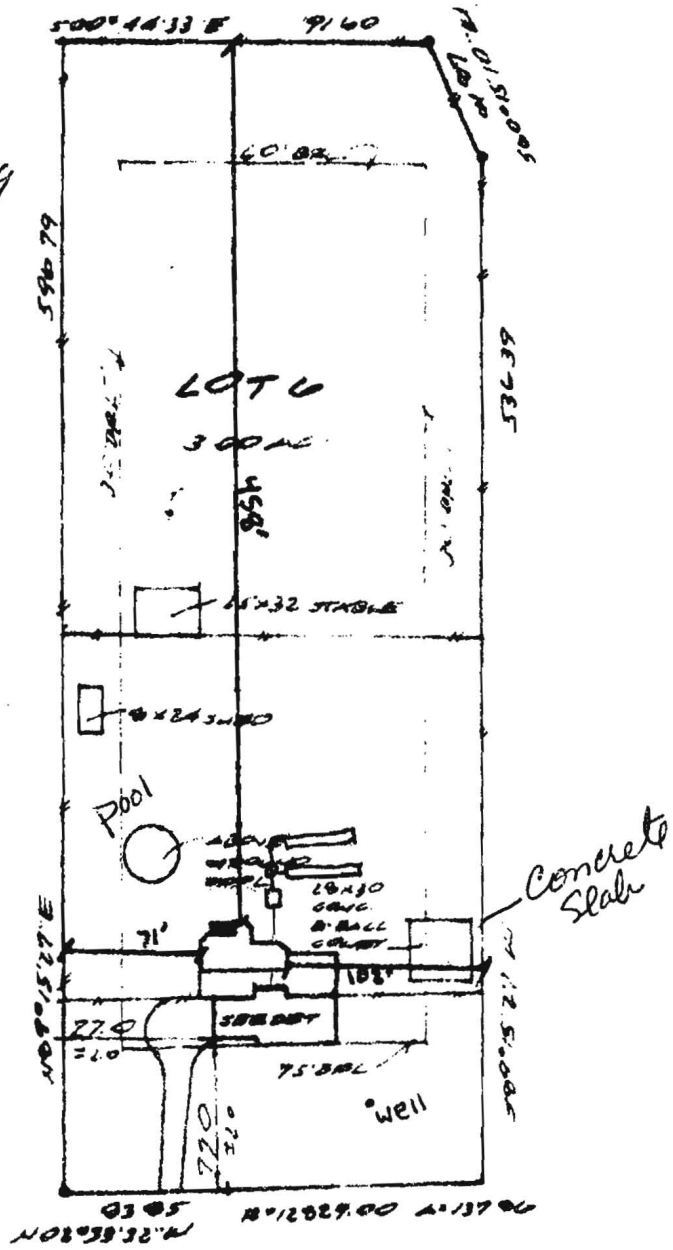

Date: 06-18-04 Scale: 1" = 100' Drn: B.D

Plat Book:

Plat No.: 7614 NO TITLE REPORT FURNISHED

Work Order: 04-3559

Address: 13920 OLD ROVER MILL ROAD

District: 3

Jurisdiction: HOWARD COUNTY, MD

LOCATION DRAWING
LOT 6
ROVER MEADOWS

Surveyor's Certification

I hereby certify that the survey shown hereon is correct to the best of my knowledge and that, unless noted otherwise, it has been prepared utilizing description of record. This survey is not a boundary survey and the location existence of property corners is neither guaranteed nor implied. Fence lines if shown, are approximate in location. This property does not lie within a 100 year flood plain according to FEMA insurance maps as interpreted by the originator unless otherwise shown hereon. Building restriction lines shown are as per available information and are subject to the interpretation of the originator

Stephen J. Westhold

NOTE: This plat is of benefit to a consumer only insofar as it is required by a lender or a title insurance company or its agent in connection with contemplated transfer, financing or refinancing. This plat is not to be relied upon for the establishment or location of fences, garages, buildings, or other existing or future improvements. This plat does not provide for the accurate identification of

MSI

Meridian Surveys, Inc.
811 Russell Avenue
Suite #303
Gaithersburg, MD 20879