Building Permit Application

Howard County Maryland
Department of Inspections, Licenses and Permits
3430 Court House Drive
Permits: 410-313-2455
www.howardcountymd.gov

Health

Date Received: _____

Permit No.: B16000556

Building Address: 4329 Buckskin Wood Dr
City: Elliott City State: MD Zip Code: 21042
Suite/Apt. #: _____ SDP/WP/BA #: _____
Census Tract: _____ Subdivision: _____
Section: _____ Area: _____ Lot: 7
Tax Map: 22 Parcel: 634777 Grid: 21
Zoning: RESIDENTIAL RREDO Map Coordinates: _____ Lot Size: 40,142sf

Existing Use: Residential
Proposed Use: Residential
Estimated Construction Cost: $ 2500
Description of Work: Place stone patio and Canopy (12x12)

Occupant or Tenant: OWNER OCCUPIED
Was tenant space previously occupied? ☐Yes ☐No
Contact Name: OWNER
Address: _____
City: _____ State: _____ Zip Code: _____
Phone: _____ Fax: _____
Email: _____

Property Owner's Name: Gerald & Patricia Jannetti
Address: 4329 Buckskin Wood Dr
City: Elliott City State: MD Zip Code: 21042
Phone: 410 241 3164 Fax: _____
Email: Jannetti@Pbworld.com

Applicant's Name & Mailing Address, (If other than stated herein)
Applicant's Name: SAME
Address: _____
City: _____ State: _____ Zip Code: _____
Phone: _____ Fax: _____
Email: _____

Contractor Company: NONE / OWNER
Contact Person: _____
Address: _____
City: _____ State: _____ Zip Code: _____
License No.: _____
Phone: _____ Fax: _____
Email: _____

Engineer/Architect Company: _____
Responsible Design Prof.: _____
Address: _____
City: _____ State: _____ Zip Code: _____
Phone: _____ Fax: _____
Email: _____

Commercial Building Characteristics	*Residential Building Characteristics*
Height:	☑ SF Dwelling ☐ SF Townhouse
No. of stories:	Depth Width
Gross area, sq. ft./floor:	1st floor:
	2nd floor:
Area of construction (sq. ft.):	Basement:
	☑ Finished Basement
Use group:	☐ Unfinished Basement
	☐ Crawl Space
Construction type:	☐ Slab on Grade
☐ Reinforced Concrete	No. of Bedrooms: 5
☐ Structural Steel	*Multi-family Dwelling*
☐ Masonry	No. of efficiency units:
☑ Wood Frame	No. of 1 BR units:
☐ State Certified Modular	No. of 2 BR units:
	No. of 3 BR units:
	Other Structure:
	Dimensions:
➢ Roadside Tree Project Permit	Footings:
☐Yes ☐No	Roof:
Roadside Tree Project Permit #	☐ State Certified Modular
	☐ Manufactured Home

Utilities	
Water Supply	
☐ Public	
☑ Private	
Sewage Disposal	
☐ Public	
☑ Private	
Electric: ☑ Yes ☐ No	
Gas: ☑ Yes ☐ No	
Heating System	
☐ Electric ☐ Oil	
☑ Natural Gas ☐ Propane Gas	
☐ Other:	
Sprinkler System:	
☐ Yes ☑ No	
Grading Permit Number:	14427
Building Shell Permit Number:	

THE UNDERSIGNED HEREBY CERTIFIES AND AGREES AS FOLLOWS: (1) THAT HE/SHE IS AUTHORIZED TO MAKE THIS APPLICATION; (2) THAT THE INFORMATION IS CORRECT; (3) THAT HE/SHE WILL COMPLY WITH ALL REGULATIONS OF HOWARD COUNTY WHICH ARE APPLICABLE THERETO; (4) THAT HE/SHE WILL PERFORM NO WORK ON THE ABOVE REFERENCED PROPERTY NOT SPECIFICALLY DESCRIBED IN THIS APPLICATION; (5) THAT HE/SHE GRANTS COUNTY OFFICIALS THE RIGHT TO ENTER ONTO THIS PROPERTY FOR THE PURPOSE OF INSPECTING THE WORK PERMITTED AND POSTING NOTICES.

Applicant's Signature — *Print Name*: Gerald S. Jannetti

Email Address: Jannetti@Pbworld.com — *Date*: 2.18.16

Title/Company

Checks Payable to: DIRECTOR OF FINANCE OF HOWARD COUNTY
PLEASE WRITE NEATLY & LEGIBLY
-FOR OFFICE USE ONLY-

AGENCY	DATE	SIGNATURE OF APPROVAL
State Highways		
Building Officials	2/18/16	
PSZA (Zoning)		
PSZA (Engineering)		
Health	2/18/16	H. Osworth

Is Sediment Control approval required for issuance? ☐ Yes ☐ No
☐ CONTINGENCY CONSTRUCTION START

DPZ SETBACK INFORMATION	
Front:	
Rear:	
Side:	
Side St.:	
All minimum setbacks met?	☐ Yes ☐ No
Is Entrance Permit Required?	☐ Yes ☐ No
Historic District?	☐ Yes ☐ No
Lot Coverage for New Town Zone:	
SDP/Red-line approval date:	

Filing Fee	$	25 cw
Permit Fee	$	25.92
Tech Fee	$	2.59
Excise Tax	$	
PSFS	$	
Guaranty Fund	$	
Add'l per Fee	$	
Total Fees	$	53.51
Sub- Total Paid	$	
Balance Due	$	
Check	#	

Distribution of Copies: White: Building Officials Green: PSZA,Zoning Yellow: PSZA,Engineering Pink: Health Gold: SHA

T:\Operations\Updated Forms\Building applmp 8.2012.docx

APPROVED
WALK-THRU BUILDING PERMIT
BP#_____ A#_____
APP. SAN M. Oswald DATE: 2/18/16
DESC. OF WORK: Install stone patio & canopy (12'x12')

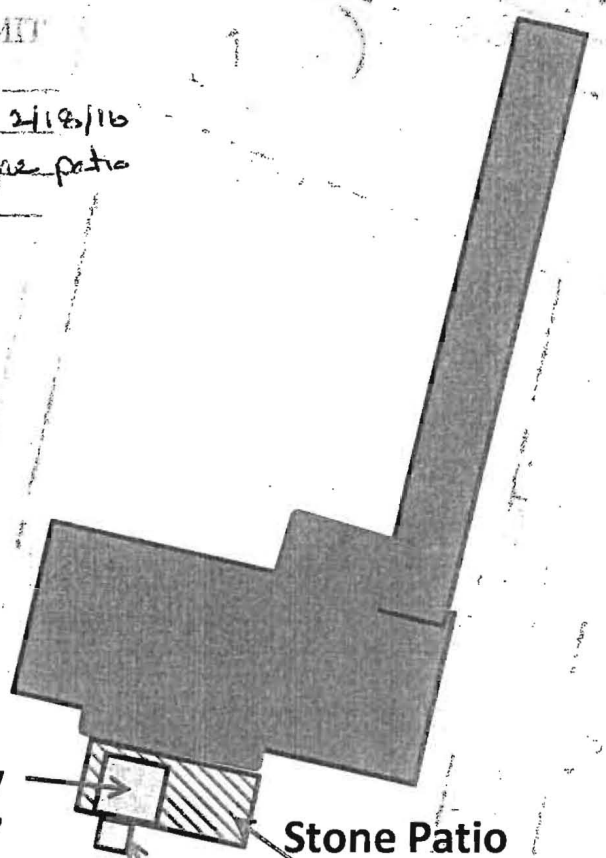

4329 Buckskin Wood Drive
Ellicott City, MD 21042

Stone Patio, Canopy
and Brick Oven

Date 2/18/16