LAYOUT _____ INSP 4 _____

INSP 2 _____ INSP 5 _____

INSP 3 _____ INSP 6 _____

ISSUE DATE: 5/16/06

APPROVAL DATE: 5/16/06

PERMIT

P 524467

A 38478

TAX ID #03-312755

ON-SITE SEWAGE DISPOSAL SYSTEM

HOWARD COUNTY HEALTH DEPARTMENT

BUREAU OF ENVIRONMENTAL HEALTH

Hatfields Equipment IS PERMITTED TO INSTALL ☒ ALTER ☐

ADDRESS: _____ PHONE NUMBER: _____

SUBDIVISION: Triadelphia Woods LOT NUMBER: 30

ADDRESS: 12667 Golden Oak Drive PROPERTY OWNER: John Deleonibus

SEPTIC TANK CAPACITY (GALLONS): 1500 OUTLET BAFFLE FILTER REQUIRED ☐

PUMP CHAMBER CAPACITY (GALLONS): n/a COMPARTMENTED TANK REQUIRED ☒

NUMBER OF BEDROOMS: 5

SQUARE FEET PER BEDROOM: 180

LINEAR FEET OF TRENCH REQUIRED: 300 HOUSE SERVED BY PUBLIC WATER ☐

TRENCHES:	
LOCATION:	Tie in new addition to existing septic system in support of building permit approved.
NOTES:	

PLANS APPROVED: Sara Fegel **Reviewed by:** _____ DATE: 5/16/06

NOTES: PERMIT VOID AFTER 2 YEARS
CONTRACTOR IS RESPONSIBLE FOR SCHEDULING A PRE-CONSTRUCTION INSPECTION FOR ALL INSTALLATIONS
WATERTIGHT SEPTIC TANKS REQUIRED
ALL PARTS OF SEPTIC SYSTEM SHALL BE 100 FEET FROM ANY WATER WELL UNLESS SPECIFICALLY AUTHORIZED
MANHOLE RISERS REQUIRED ON ALL SEPTIC TANKS AND PUMP CHAMBERS UNLESS SPECIFICALLY AUTHORIZED
CONTRACTOR RESPONSIBLE FOR COMPLIANCE WITH APPLICABLE REGULATIONS, GUIDELINES AND THE TERMS OF THIS PERMIT

NEITHER THE HOWARD COUNTY COUNCIL NOR THE HEALTH DEPARTMENT IS RESPONSIBLE FOR THE SUCCESSFUL OPERATION OF ANY SYSTEM
PERMITTEE RESPONSIBLE FOR OBTAINING FINAL APPROVAL ON THIS PERMIT
CALL 410-313-1771 FOR INSPECTION OF SEPTIC SYSTEM

P524467

NOT TO SCALE

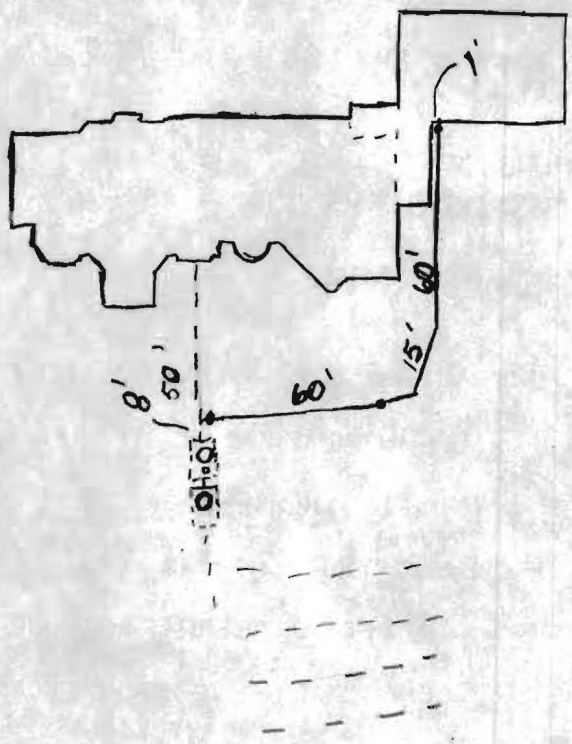

ROAD

TRENCH/DRAINFIELD DATA

WIDTH _____ INLET _____ BOTTOM _____

NUMBER OF TRENCHES _____

TOTAL LENGTH _____

ABSORPTION AREA _____

DISTRIBUTION BOX LEVEL _____

DISTRIBUTION BOX BAFFLE _____

DISTRIBUTION BOX PORT _____

SEPTIC TANK DATA

SEPTIC TANK 1 LEVEL _____

CAPACITY _____ GAL

SEAM LOC _____

TANK LID DEPTH _____

BAFFLES _____

BAFFLE FILTER _____

MANHOLE LOC _____

6" PORT LOC _____

WATERTIGHT TEST _____

SEPTIC TANK 2 LEVEL _____

CAPACITY _____ GAL

SEAM LOC _____

TANK LID DEPTH _____

BAFFLES _____

BAFFLE FILTER _____

MANHOLE LOC _____

6" PORT LOC _____

WATERTIGHT TEST _____

PRE-CONSTRUCTION _____

INSTALLATION Install line from new Addition to Existing Septic line. (GAC) Install ok to cover entire line packed in 1" gravel for compaction purposes (GAC)

FINAL INSPECTOR [signature] DATE OF APPROVAL 5/16/06

SITE PLAN

NORTH

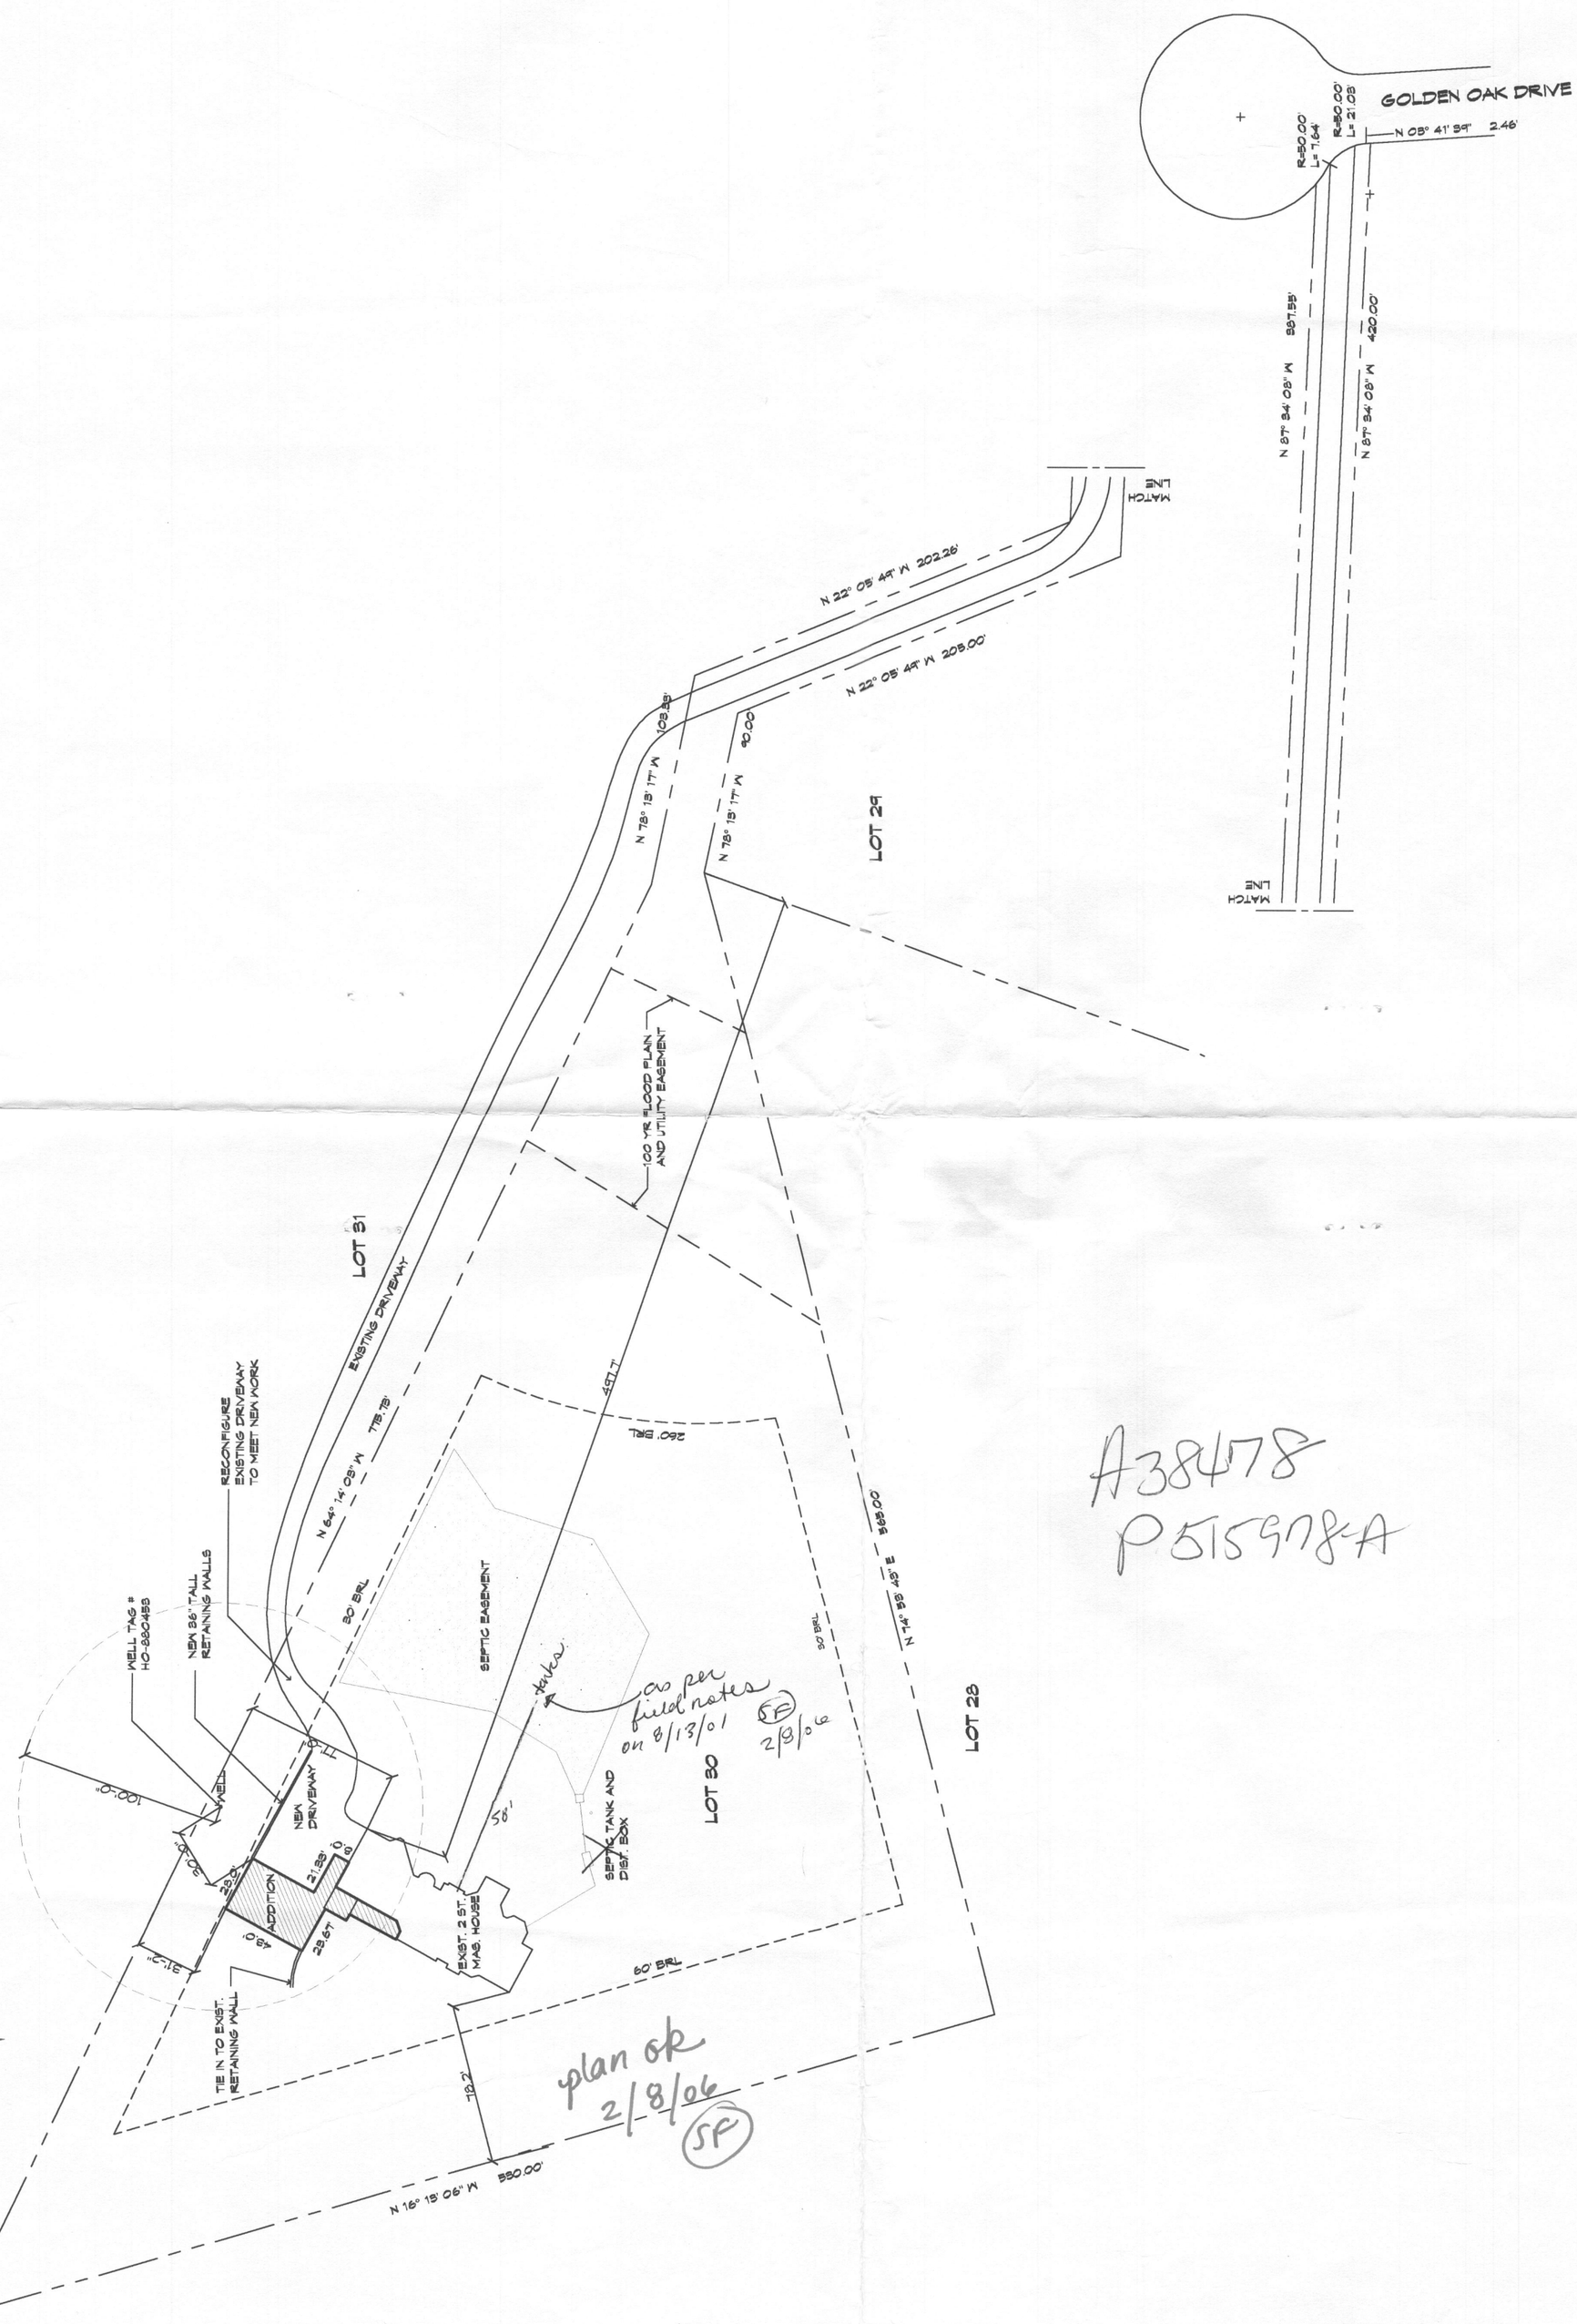

A38478
P515978-A

Plan not readable scale

plan ok 2/8/06 SP

- Next addition may need to be upgrade trench system depending on permit description
- ~~Septi tank location not correct~~
- ~~will need to add 250 gal tank.~~
- ~~will need to add addl trench.~~

REV.	
5/4/05	
1/9/06	
4/14/05	
SCALE: 3/16"=1'-0"	
S1	

SEAL

DELEONIBUS RESIDENCE ADDITION
12667 GOLDEN OAK DRIVE
ELLICOTT CITY, MARYLAND 21744

the Griffmore group
4231 Linthicum Road
Dayton, MD. 21036
phone. 401.531.8105
fax. 410.484.6444

JACKSON DESIGN GROUP
8508 CHURCHILL DOWNS RD.
GAITHERSBURG, MD. 20882
301.519.7485
301.519.0613 fax
jack@jacksondesigngroup.net

HOWARD COUNTY HEALTH DEPARTMENT
Completed Septic System

P 515978-A A 38478

DATE 8/08/2001

LOCATION 12667 Golden Oak Drive
Triadelphia Woods

LOT 30

APPLICANT

OWNER John Delronibus

PERMITTEE Union Paving Company, Inc.

HD-11

APPLICATION
HOLD ( )
APPROVED ( )
REJECTED ( )

INSTALLATION
HOLD ( )
APPROVED ( )

APPROVED
DATE 8/13/2001

-230-300 Hatfields

12667
Golden Oak Dr
Line from addition
to existing sewer
line