C 1 6944 — SEQUENCE NO. (WRA USE ONLY)
1 2 3 (SEQ. NO.) 6
(THIS NUMBER IS TO BE PUNCHED IN COLS. 3-6 ON ALL CARDS)

STATE OF MARYLAND
WATER RESOURCES ADMINISTRATION
TAWES STATE OFFICE BLDG., ANNAPOLIS, MD. 21401
WELL COMPLETION REPORT

THIS REPORT MUST BE SUBMITTED WITHIN 30 DAYS AFTER WELL COMPLETION

FILL IN THIS FORM COMPLETELY

COUNTY NUMBER

DATE RECEIVED (WRA USE ONLY) 8-13

DATE WELL COMPLETED 6/15/78 (15–20)

DEPTH OF WELL 120 (22 (TO NEAREST FOOT) 26)

PERMIT NO. FROM "PERMIT TO DRILL WELL" (28 29 30 31 32 33 34 35 36 37)

DRILLERS IDENTIFICATION NO. 42

OWNER Wilson, Ed (LAST NAME / FIRST NAME)

STREET OR RFD P.O. Box 32 POST OFFICE Ashton, Md.

WELL DESCRIPTION

WELL LOG

STATE THE KIND OF FORMATIONS PENETRATED, THEIR COLOR, DEPTH, THICKNESS AND IF WATER BEARING

DESCRIPTION (USE ADDITIONAL SHEETS IF NECESSARY)	FEET FROM	FEET TO	CHECK IF WATER BEARING
Top Soil	0	3	
SANDY	3	30	
SAND & GRAVEL	30	50	
Mica	50	120	

GROUTING RECORD

WELL HAS BEEN GROUTED (CIRCLE APPROPRIATE BOX) YES [Y] (44) NO [N] (44)

TYPE OF GROUTING MATERIAL (CIRCLE BOX): CEMENT [C M] (45 46) BENTONITE CLAY [B C] (45 46)

NO. OF BAGS 12 NO. OF POUNDS 1200

GALLONS OF WATER 60

DEPTH OF GROUT SEAL (TO NEAREST FOOT)

FROM 0 (48) FT. TO 40 (52 54) FT. 58

(ENTER 0 IF FROM SURFACE)

CASING RECORD

CASING TYPES — INSERT APPROPRIATE CODE BELOW

[S T] STEEL [C O] CONCRETE [P L] PLASTIC [O T] OTHER

MAIN CASING TYPE [S T] (60 61)

NOMINAL DIAMETER TOP (MAIN) CASING (NEAREST INCH) 6 (63 64)

TOTAL DEPTH OF MAIN CASING (NEAREST FOOT) 45 (66 70)

OTHER CASING (IF USED)

EACH CASING

DIAMETER (INCH)	DEPTH (FEET) FROM	TO

SCREEN RECORD

SCREEN TYPE OR OPEN HOLE — INSERT APPROPRIATE CODE BELOW

[S T] STEEL [B R] BRASS OR BRONZE [H O] OPEN HOLE [P L] PLASTIC [O T] OTHER

C 2 (1 2 3 (SEQ. NO.) 6)

DEPTH (NEAREST WHOLE FOOT)

EACH SCREEN

		FROM	TO
1	40 (8 9)	73 (11 15)	120 (17 21)
2	(23 24)	(26 30)	(32 36)
3	(38 39)	(41 45)	(47 51)

SLOT SIZE 1. ____ 2. ____ 3. ____

DIAMETER OF SCREEN ____ (56 60) (NEAREST INCH)

GRAVEL PACK FROM ____ TO ____

IF WELL DRILLED WAS A FLOWING WELL CIRCLE BOX 68 [F]

WRA USE ONLY (NOT TO BE FILLED IN BY DRILLER)

T (70) TELESCOPE CASING — (E.R.O.S.) (72) LOG INDICATOR — W Q (74 75 76) OTHER DATA AVAILABLE

CIRCLE APPROPRIATE BOXES

[A] A WELL WAS ABANDONED AND SEALED WHEN THIS WELL WAS COMPLETED

[E] ELECTRIC LOG OBTAINED

[P] TEST WELL CONVERTED TO PRODUCTION WELL

I HEREBY CERTIFY THAT I HAVE COMPLIED WITH ALL CONDITIONS STATED ON THE ABOVE-CAPTIONED "PERMIT TO DRILL WELL", AND THAT INFORMATION CONTAINED IN THIS REPORT IS TRUE, ACCURATE, AND COMPLETE TO THE BEST OF MY KNOWLEDGE, INFORMATION AND BELIEF.

DRILLERS NAME

(PLEASE PRINT) L. F. Easterday

SIGNATURE L. F. Easterday

C 3 (1 2 3 (SEQ. NO.) 6)

PUMPING TEST

HOURS PUMPED (TO NEAREST HOUR) 3 (8 9)

PUMPING RATE (GALLONS PER MINUTE TO NEAREST GALLON) 30 (11 15)

METHOD USED TO MEASURE PUMPING RATE Bucket

WATER LEVEL: (DISTANCE FROM LAND SURFACE)

BEFORE PUMPING 30 (17 20) (NEAREST FOOT)

WHEN PUMPING 120 (22 25) (NEAREST FOOT)

TYPE OF PUMP USED (CIRCLE APPROPRIATE BOX) (FOR PUMPING TEST)

[A] AIR (27) [P] PISTON (27) [T] TURBINE (27)

[C] CENTRIFUGAL (27) [R] ROTARY (27) [O] OTHER (DESCRIBE BELOW) (27)

[J] JET (27) [S] SUBMERSIBLE (27)

PUMP INSTALLED

TYPE OF PUMP (WRITE APPROPRIATE LETTER IN BOX – SEE ABOVE: A, C, J, P, R, S, T, O) (29)

DRILLER WILL INSTALL PUMP (CIRCLE APPROPRIATE BOX) YES [Y] NO [N]

CAPACITY:

GALLONS PER MINUTE (TO NEAREST GALLON) (31 35)

PUMP HORSE POWER (37 41)

PUMP COLUMN LENGTH (NEAREST FOOT) (43 47)

CASING HEIGHT (CIRCLE APPROPRIATE BOX AND ENTER CASING HEIGHT)

[+] ABOVE / [–] BELOW LAND SURFACE (NEAREST FOOT) (49 50 51)

LOCATION OF WELL ON LOT

N ↑ SHOW PERMANENT STRUCTURE SUCH AS BUILDINGS, SEPTIC TANKS, AND/OR OTHER LAND MARKS AND INDICATE NOT LESS THAN TWO DISTANCES (MEASUREMENTS TO WELL).

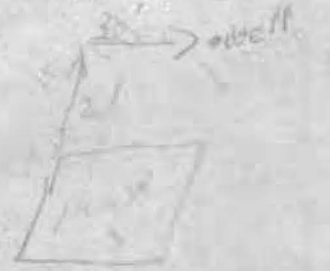

HEALTH