


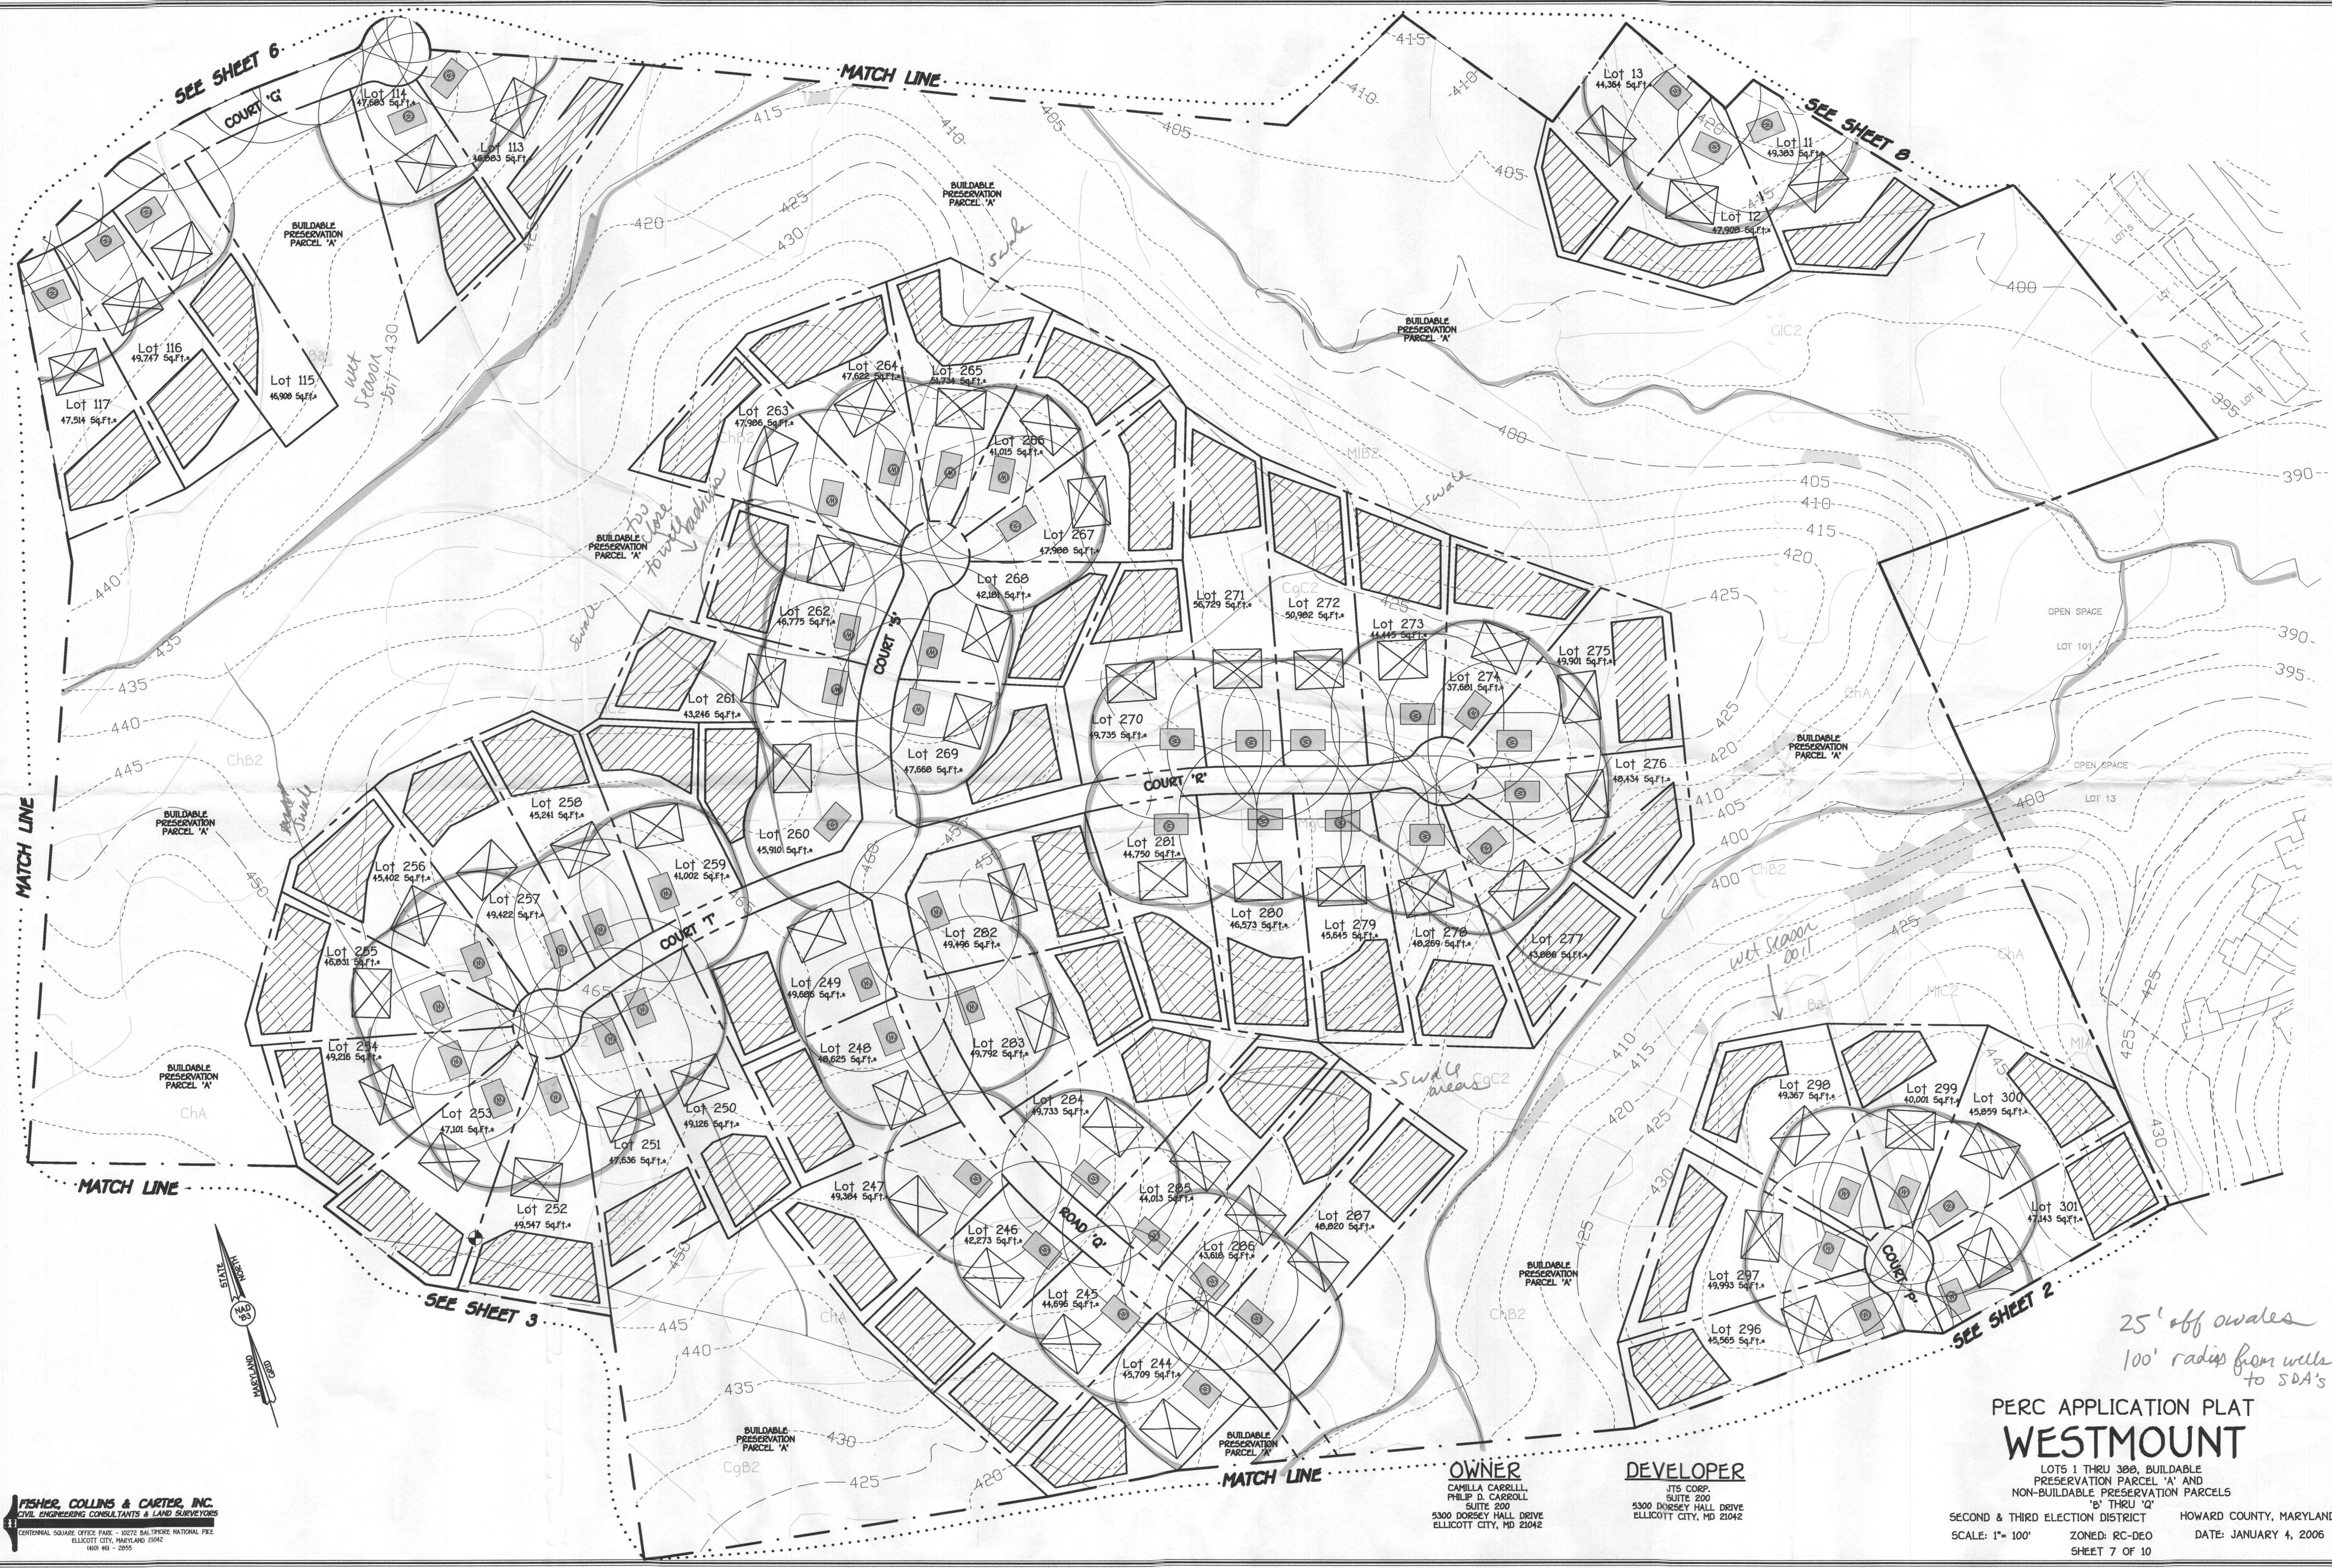

FISHER, COLLINS & CARTER, INC.
 CIVIL ENGINEERING CONSULTANTS & LAND SURVEYORS
 ELLICOTT CITY, MARYLAND 21042
 (410) 461-2895

OWNER
 CAMILLA CARROLL
 PHILIP D. CARROLL
 SUITE 200
 5300 DORSEY HALL DRIVE
 ELLICOTT CITY, MD 21042

DEVELOPER
 JTS CORP.
 SUITE 200
 5300 DORSEY HALL DRIVE
 ELLICOTT CITY, MD 21042

PERC APPLICATION PLAT **WESTMOUNT**

LOTS 1 THRU 308, BUILDABLE PRESERVATION PARCEL 'A' AND NON-BUILDABLE PRESERVATION PARCELS 'B' THRU 'Q'

SECOND & THIRD ELECTION DISTRICT
 SCALE: 1"= 100' ZONED: RC-DEO SHEET 7 OF 10
 HOWARD COUNTY, MARYLAND
 DATE: JANUARY 4, 2006

K:\Drawings\330658 Carroll Property\30658 Parc Plan\reworking_1192006 9:49:45 AM 1:1