



Building Permit Application

Howard County Maryland
Department of Inspections, Licenses and Permits
3430 Court House Drive
Permits: 410-313-2455
www.howardcountymd.gov

Date Received: _____

Permit No.: _____

Building Address: 14800 Tridelphia Rd
City: Glen Elg State: MD Zip Code: 21737
Suite/Apt. #: _____ SDP/WP/BA #: _____
Census Tract: _____ Subdivision: Woodfield
Section: _____ Area: _____ Lot: _____
Tax Map: 21 Parcel: 209 Grid: 22
Zoning: _____ Map Coordinates: _____ Lot Size: 4.28
Existing Use: SFD
Proposed Use: In ground pool
Estimated Construction Cost: \$ 30,000.00
Description of Work: 42 X 24 in ground concrete pool, depth 3' to 8', fence to code by owner
Occupant or Tenant: _____
Was tenant space previously occupied? ☐ Yes ☐ No
Contact Name: _____
Address: _____
City: _____ State: _____ Zip Code: _____
Phone: _____ Fax: _____
Email: _____

Property Owner's Name: Kenneth Khandagale
Address: 14800 Tridelphia Rd
City: Glen Elg State: MD Zip Code: 21737
Phone: _____ Fax: _____
Email: _____
Applicant's Name & Mailing Address (If other than stated herein)
Applicant's Name: Karen Rowley
Address: _____
City: _____ State: _____ Zip Code: _____
Phone: 410 507 7705 Fax: _____
Email: Kkpermits@Seyahoo.com
Contractor Company: _____
Contact Person: _____
Address: _____
City: _____ State: _____ Zip Code: _____
License No.: _____
Phone: _____ Fax: _____
Email: _____
Engineer/Architect Company: _____
Responsible Design Prof.: _____
Address: _____
City: _____ State: _____ Zip Code: _____
Phone: _____ Fax: _____
Email: _____

Commercial Building Characteristics	Residential Building Characteristics
Height:	☐ SF Dwelling ☐ SF Townhouse
No. of stories:	<u>Depth</u> <u>Width</u>
Gross area, sq. ft./floor:	1 st floor:
	2 nd floor:
Area of construction (sq. ft.):	Basement:
	☐ Finished Basement
Use group:	☐ Unfinished Basement
	☐ Crawl Space
<u>Construction type:</u>	☐ Slab on Grade
☐ Reinforced Concrete	No. of Bedrooms:
☐ Structural Steel	<u>Multi-family Dwelling</u>
☐ Masonry	No. of efficiency units:
☐ Wood Frame	No. of 1 BR units:
☐ State Certified Modular	No. of 2 BR units:
	No. of 3 BR units:
	Other Structure:
	Dimensions:
☒ Roadside Tree Project Permit	Footings:
☐ Yes ☐ No	Roof:
<u>Roadside Tree Project Permit #</u>	☐ State Certified Modular
	☐ Manufactured Home

Utilities	
<u>Water Supply</u>	
☐ Public	
☒ Private	
<u>Sewage Disposal</u>	
☐ Public	
☒ Private	
Electric: ☐ Yes ☐ No	
Gas: ☐ Yes ☐ No	
<u>Heating System</u>	
☐ Electric ☐ Oil	
☐ Natural Gas ☐ Propane Gas	
☐ Other:	
<u>Sprinkler System:</u>	
☐ Yes ☐ No	
<u>Grading Permit Number:</u>	
<u>Building Shell Permit Number:</u>	

THE UNDERSIGNED HEREBY CERTIFIES AND AGREES AS FOLLOWS: (1) THAT HE/SHE IS AUTHORIZED TO MAKE THIS APPLICATION; (2) THAT THE INFORMATION IS CORRECT; (3) THAT HE/SHE WILL COMPLY WITH ALL REGULATIONS OF HOWARD COUNTY WHICH ARE APPLICABLE THERETO; (4) THAT HE/SHE WILL PERFORM NO WORK ON THE ABOVE REFERENCED PROPERTY NOT SPECIFICALLY DESCRIBED IN THIS APPLICATION; (5) THAT HE/SHE GRANTS COUNTY OFFICIALS THE RIGHT TO ENTER ONTO THIS PROPERTY FOR THE PURPOSE OF INSPECTING THE WORK PERMITTED AND POSTING NOTICES.

Applicant's Signature: Karen Rowley
Email Address: _____
Title/Company: _____

Print Name: Karen Rowley
Date: 11/2/16

Checks Payable to: DIRECTOR OF FINANCE OF HOWARD COUNTY

PLEASE WRITE NEATLY & LEGIBLY

-FOR OFFICE USE ONLY-

AGENCY	DATE	SIGNATURE OF APPROVAL
State Highways		
Building Officials		
PSZA (Zoning)		
PSZA (Engineering)		
Health	<u>11/2/16</u>	<u>R. Buckner</u>

Is Sediment Control approval required for issuance? ☐ Yes ☐ No
☐ CONTINGENCY CONSTRUCTION START

DPZ SETBACK INFORMATION
Front: _____
Rear: _____
Side: _____
Side St.: _____
All minimum setbacks met? ☐ Yes ☐ No
Is Entrance Permit Required? ☐ Yes ☐ No
Historic District? ☐ Yes ☐ No
Lot Coverage for New Town Zone: _____
SDP/Red-line approval date: _____

Filing Fee	\$
Permit Fee	\$
Tech Fee	\$
Excise Tax	\$
PSFS	\$
Guaranty Fund	\$
Add'l per Fee	\$
Total Fees	\$
Sub-Total Paid	\$
Balance Due	\$
Check	#

istribution of Copies: White: Building Officials


Green: PSZA,Zoning

Yellow: PSZA,Engineering

Pink: Health

Gold: SHA

LOT 9

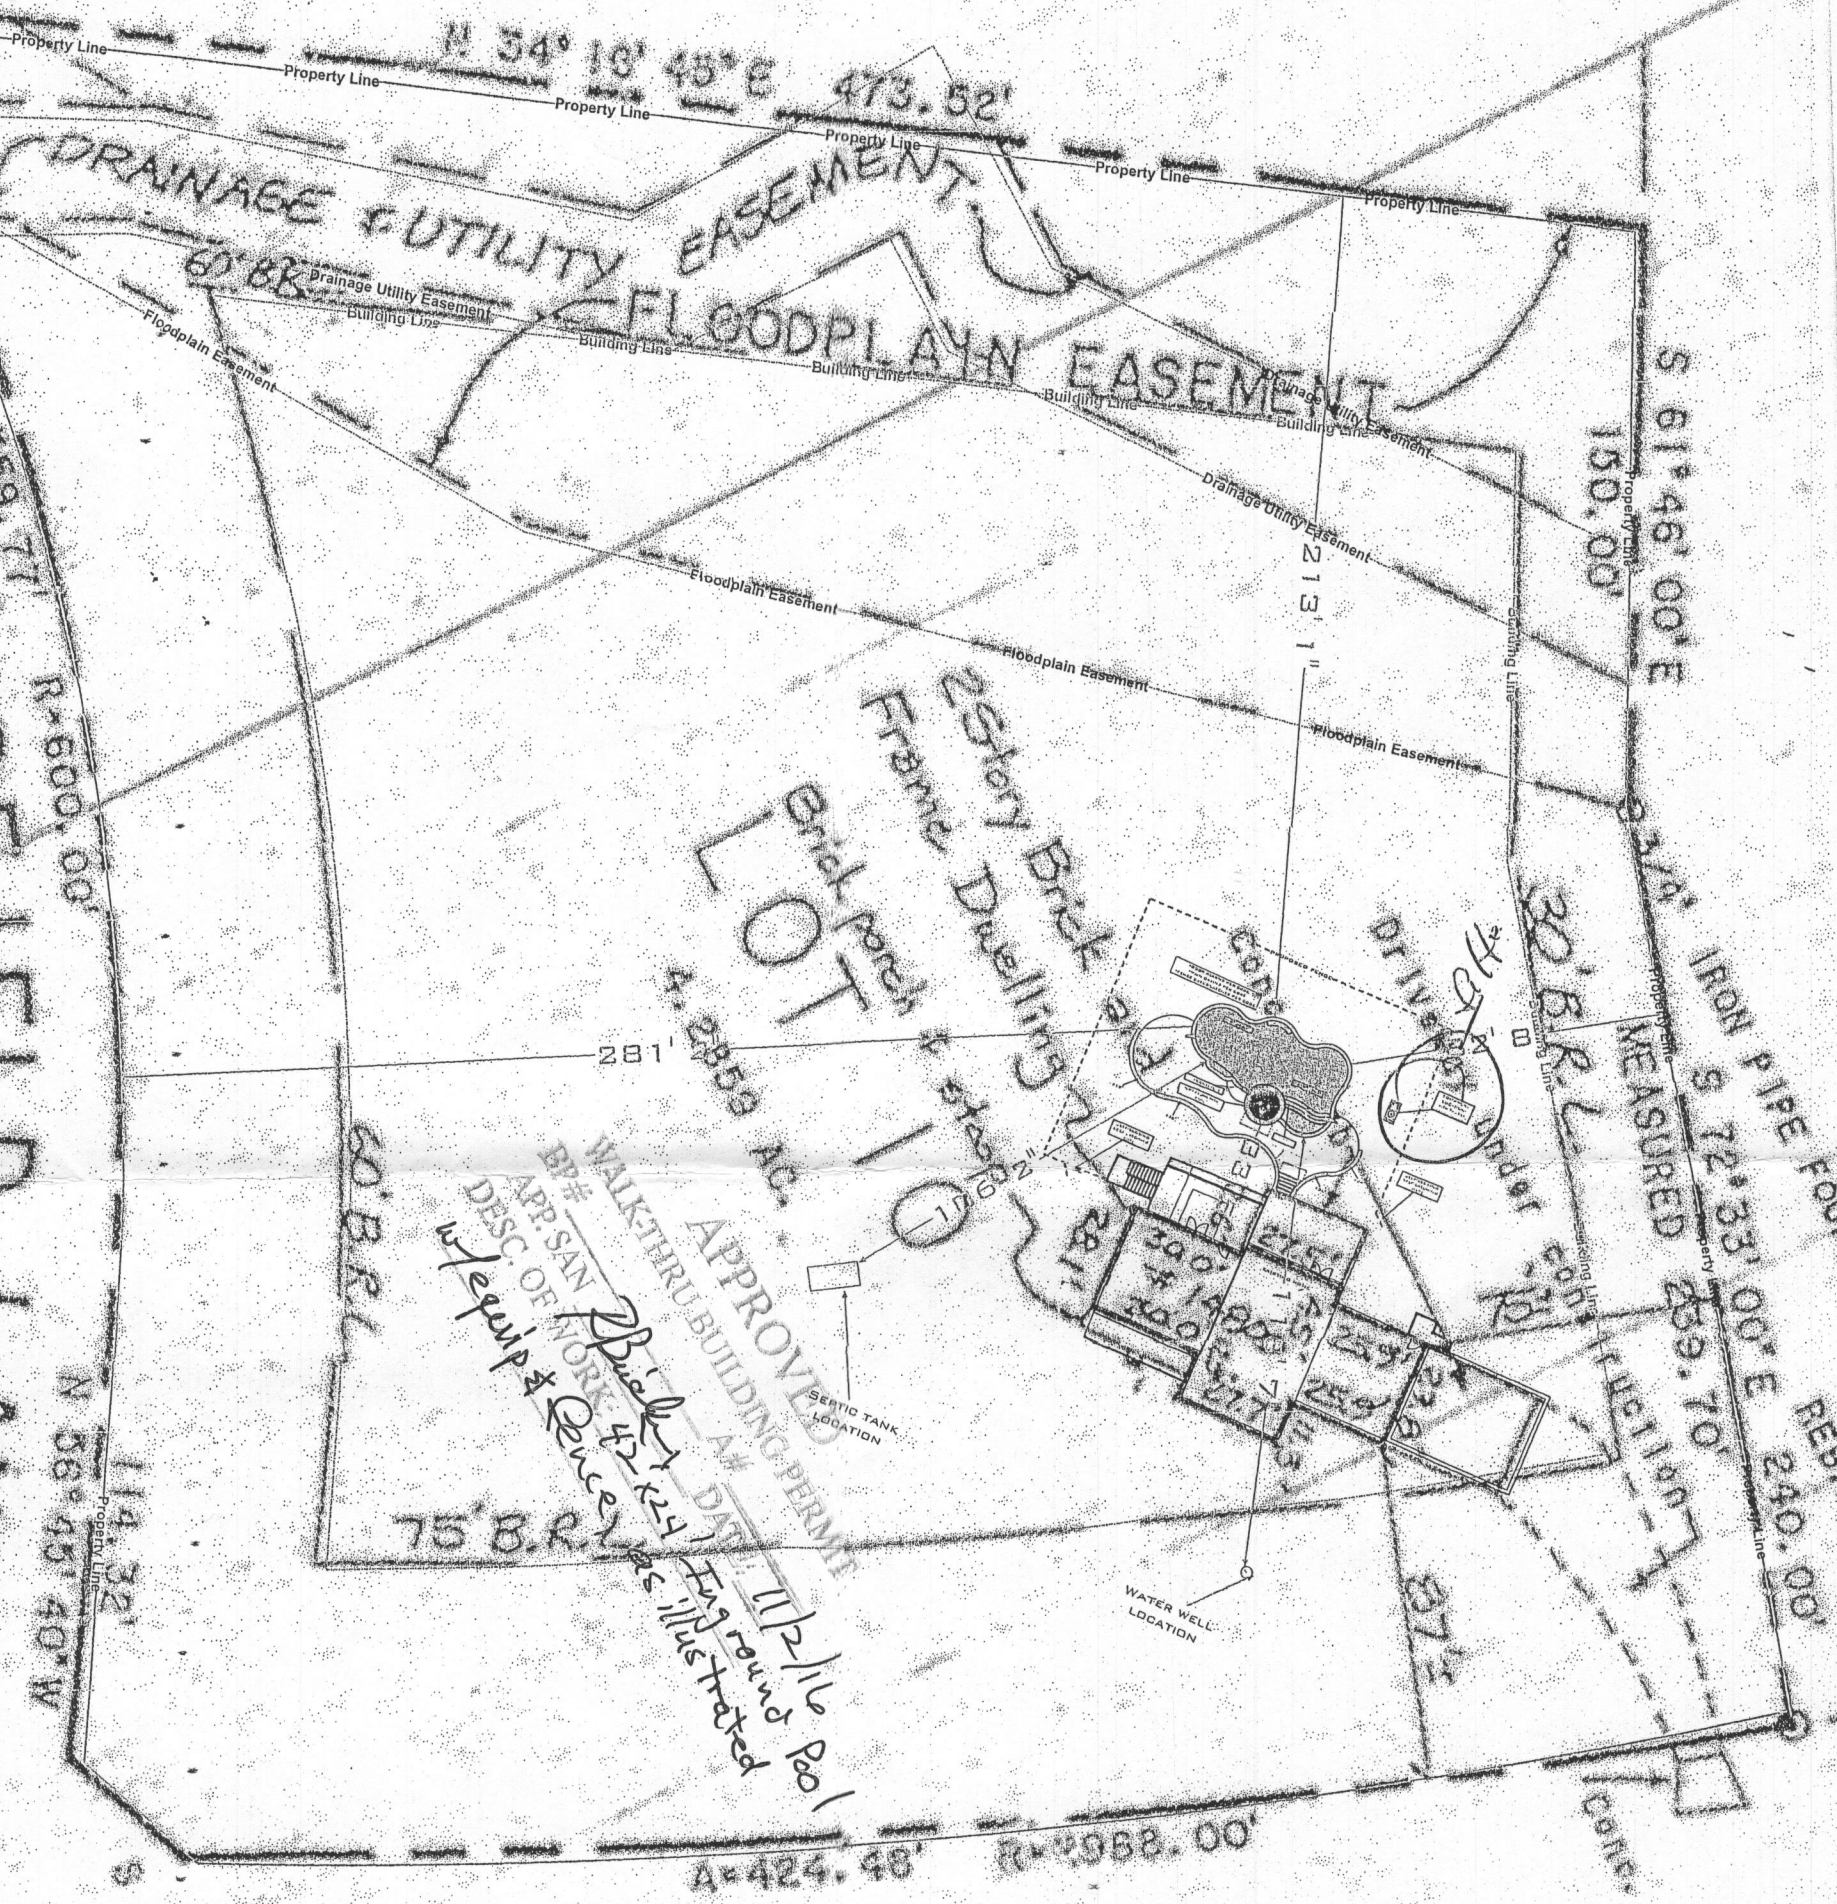

MOODFIELD LANE

TRIADELPHIA ROAD
width varies

1/50" = 1'-0"

14800 Triadelphia Rd