LAYOUT _____ INSP 4 _____

INSP 2 _____ INSP 5 _____

INSP 3 _____ INSP 6 _____

ISSUE DATE: _____

PERMIT

P 523992

APPROVAL DATE: _____

A 523992

TAX ID #05-357977

ON-SITE SEWAGE DISPOSAL SYSTEM

HOWARD COUNTY HEALTH DEPARTMENT

BUREAU OF ENVIRONMENTAL HEALTH

Lisa B. McCarthy IS PERMITTED TO INSTALL ☒ ALTER ☐

ADDRESS: 5629 Trotter Road PHONE NUMBER: 301-596-9059

SUBDIVISION: _____ LOT NUMBER: _____

ADDRESS: 5629 Trotter Road PROPERTY OWNER: Kevin & Lisa McCarthy

SEPTIC TANK CAPACITY (GALLONS): 1000 OUTLET BAFFLE FILTER REQUIRED ☐

PUMP CHAMBER CAPACITY (GALLONS) n/a COMPARTMENTED TANK REQUIRED ☒

NUMBER OF BEDROOMS: _____

SQUARE FEET PER BEDROOM: _____

LINEAR FEET OF TRENCH REQUIRED: _____ HOUSE SERVED BY PUBLIC WATER ☐

TRENCHES:	
LOCATION:	
NOTES:	In support of building permit addition to add 1 bedroom. Added a 1000 gallon septic tank, records indicate old tank was 1000 gallon. So, there are 2 1000 gallon septic tanks.

PLANS APPROVED: _____ DATE: _____

NOTES: PERMIT VOID AFTER 2 YEARS
CONTRACTOR IS RESPONSIBLE FOR SCHEDULING A PRE-CONSTRUCTION INSPECTION FOR ALL INSTALLATIONS
WATERTIGHT SEPTIC TANKS REQUIRED
ALL PARTS OF SEPTIC SYSTEM SHALL BE 100 FEET FROM ANY WATER WELL UNLESS SPECIFICALLY AUTHORIZED
MANHOLE RISERS REQUIRED ON ALL SEPTIC TANKS AND PUMP CHAMBERS UNLESS SPECIFICALLY AUTHORIZED
CONTRACTOR RESPONSIBLE FOR COMPLIANCE WITH APPLICABLE REGULATIONS, GUIDELINES AND THE TERMS OF THIS PERMIT

NEITHER THE HOWARD COUNTY COUNCIL NOR THE HEALTH DEPARTMENT IS RESPONSIBLE FOR THE SUCCESSFUL OPERATION OF ANY SYSTEM

PERMITTEE RESPONSIBLE FOR OBTAINING FINAL APPROVAL ON THIS PERMIT

ALL 410-313-1771 FOR INSPECTION OF SEPTIC SYSTEM

TROTTER RD

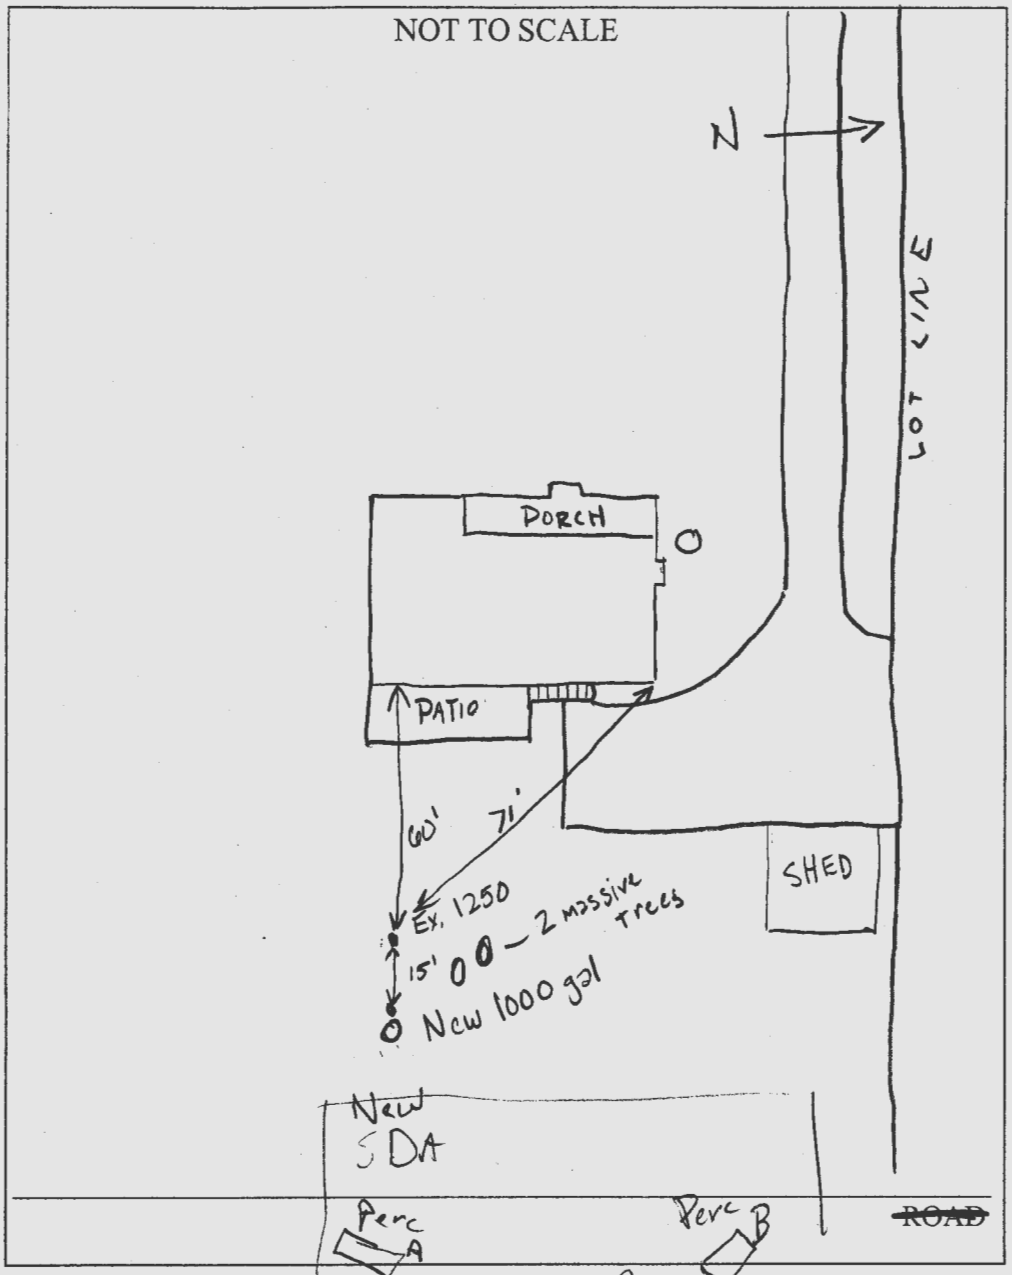

TRENCH/DRAINFIELD DATA

WIDTH	INLET	BOTTOM

NUMBER OF TRENCHES _____

TOTAL LENGTH _____

ABSORPTION AREA _____

DISTRIBUTION BOX LEVEL _____

DISTRIBUTION BOX BAFFLE _____

DISTRIBUTION BOX PORT _____

SEPTIC TANK DATA

SEPTIC TANK 1 LEVEL Existing

CAPACITY 1250 GAL

SEAM LOC ?

TANK LID DEPTH ?

BAFFLES ?

BAFFLE FILTER No

MANHOLE LOC None

6" PORT LOC ? MID

WATERTIGHT TEST No

SEPTIC TANK 2 LEVEL Yes ?

CAPACITY 1000? GAL

SEAM LOC Top

TANK LID DEPTH ~4'

BAFFLES yes ?

BAFFLE FILTER No

MANHOLE LOC MID

6" PORT LOC Inlet

WATERTIGHT TEST N/A

PRE-CONSTRUCTION Upgrade for BP per K. Bell. Addition of New 1000gallon S. tank. Work was covered when arrived @ site. This

INSTALLATION was ok'ed by S. Oster. GAC

FINAL INSPECTOR Gabriel A Creighton DATE OF APPROVAL 2/21/06

4/17/03
Ok for addition
JB

for what?
Kitchen exp

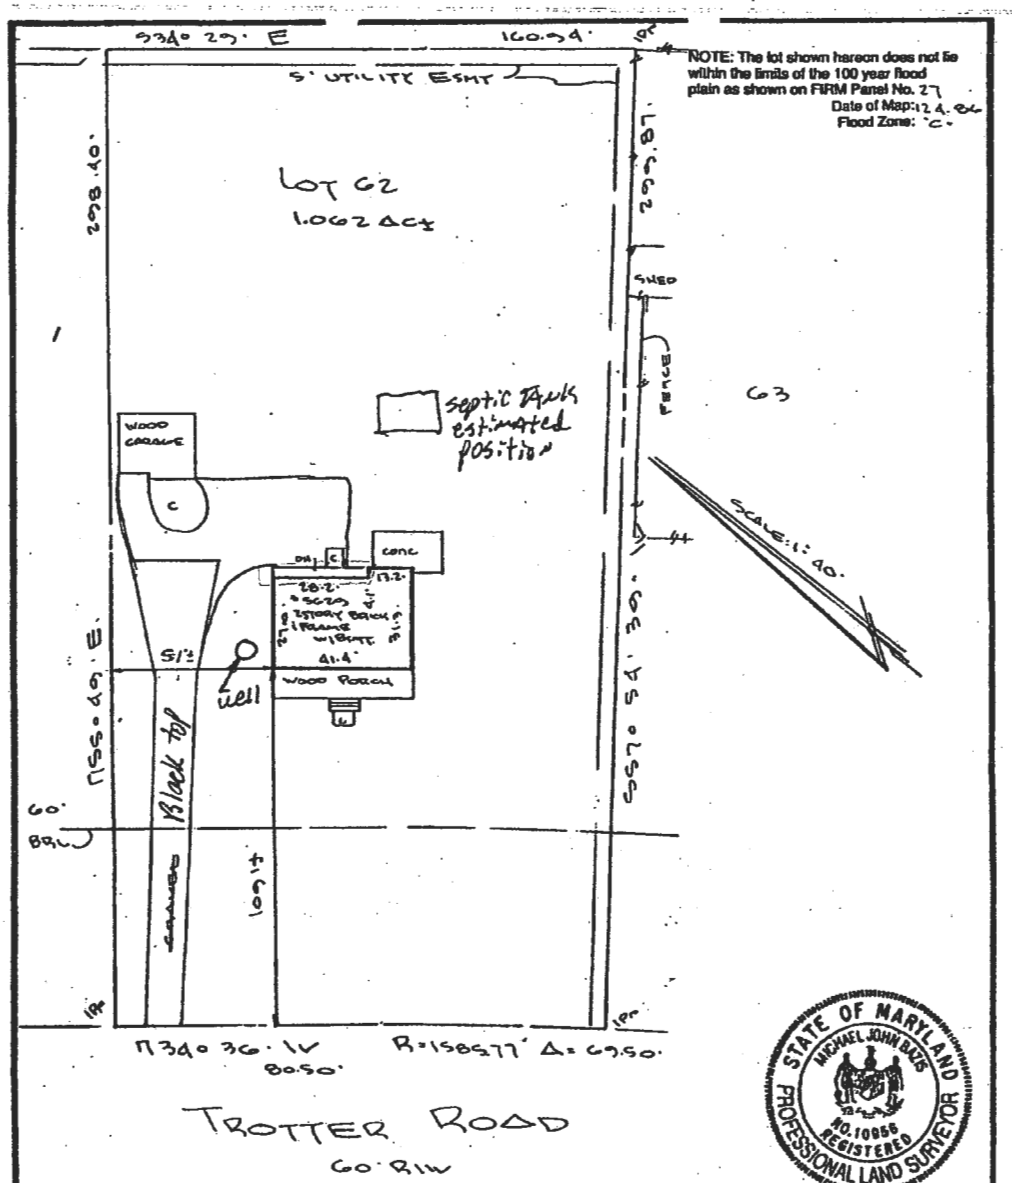

NOTE: The lot shown hereon does not lie within the limits of the 100 year flood plain as shown on FIRM Panel No. 27
Date of Map: 12.4.86
Flood Zone: 'C'

STATE OF MARYLAND
MICHAEL JOHN BAZIS
NO. 10956
REGISTERED
PROFESSIONAL LAND SURVEYOR

IMPROVEMENT LOCATION SURVEY
LOT 62
CRISWOOD MANOR
SECTION TWO
HOWARD COUNTY, MD

THIS SURVEY IS FOR TITLE PURPOSES ONLY

SURVEYOR'S CERTIFICATE

I hereby certify that the property delineated hereon is in accordance with the Plat of Subdivision and/or deed of record, that the improvements were located by accepted field practices and include permanent visible structures and encroachments, if any. This Plat is not for determining property lines or for construction of improvements, but prepared for exclusive use of present owners of property and also those who purchase, mortgage, or guarantee the title thereto, within six months from date hereof, and as to them I warrant the accuracy of this Plat.

Michael J. Bazis RPLS #10956

JOB # 93.1620.H	DATE 6.10.93	**R. C. KELLY**
FIELD J.BB	DRAFT KAHO	**LAND SURVEYORS**
	P.B.5 P# 52	10111 COLESVILLE ROAD, SUITE 123 SILVER SPRING, MD 20901 301-593-8005
	SCALE: 1" = 40'	**& ASSOC., INC.**