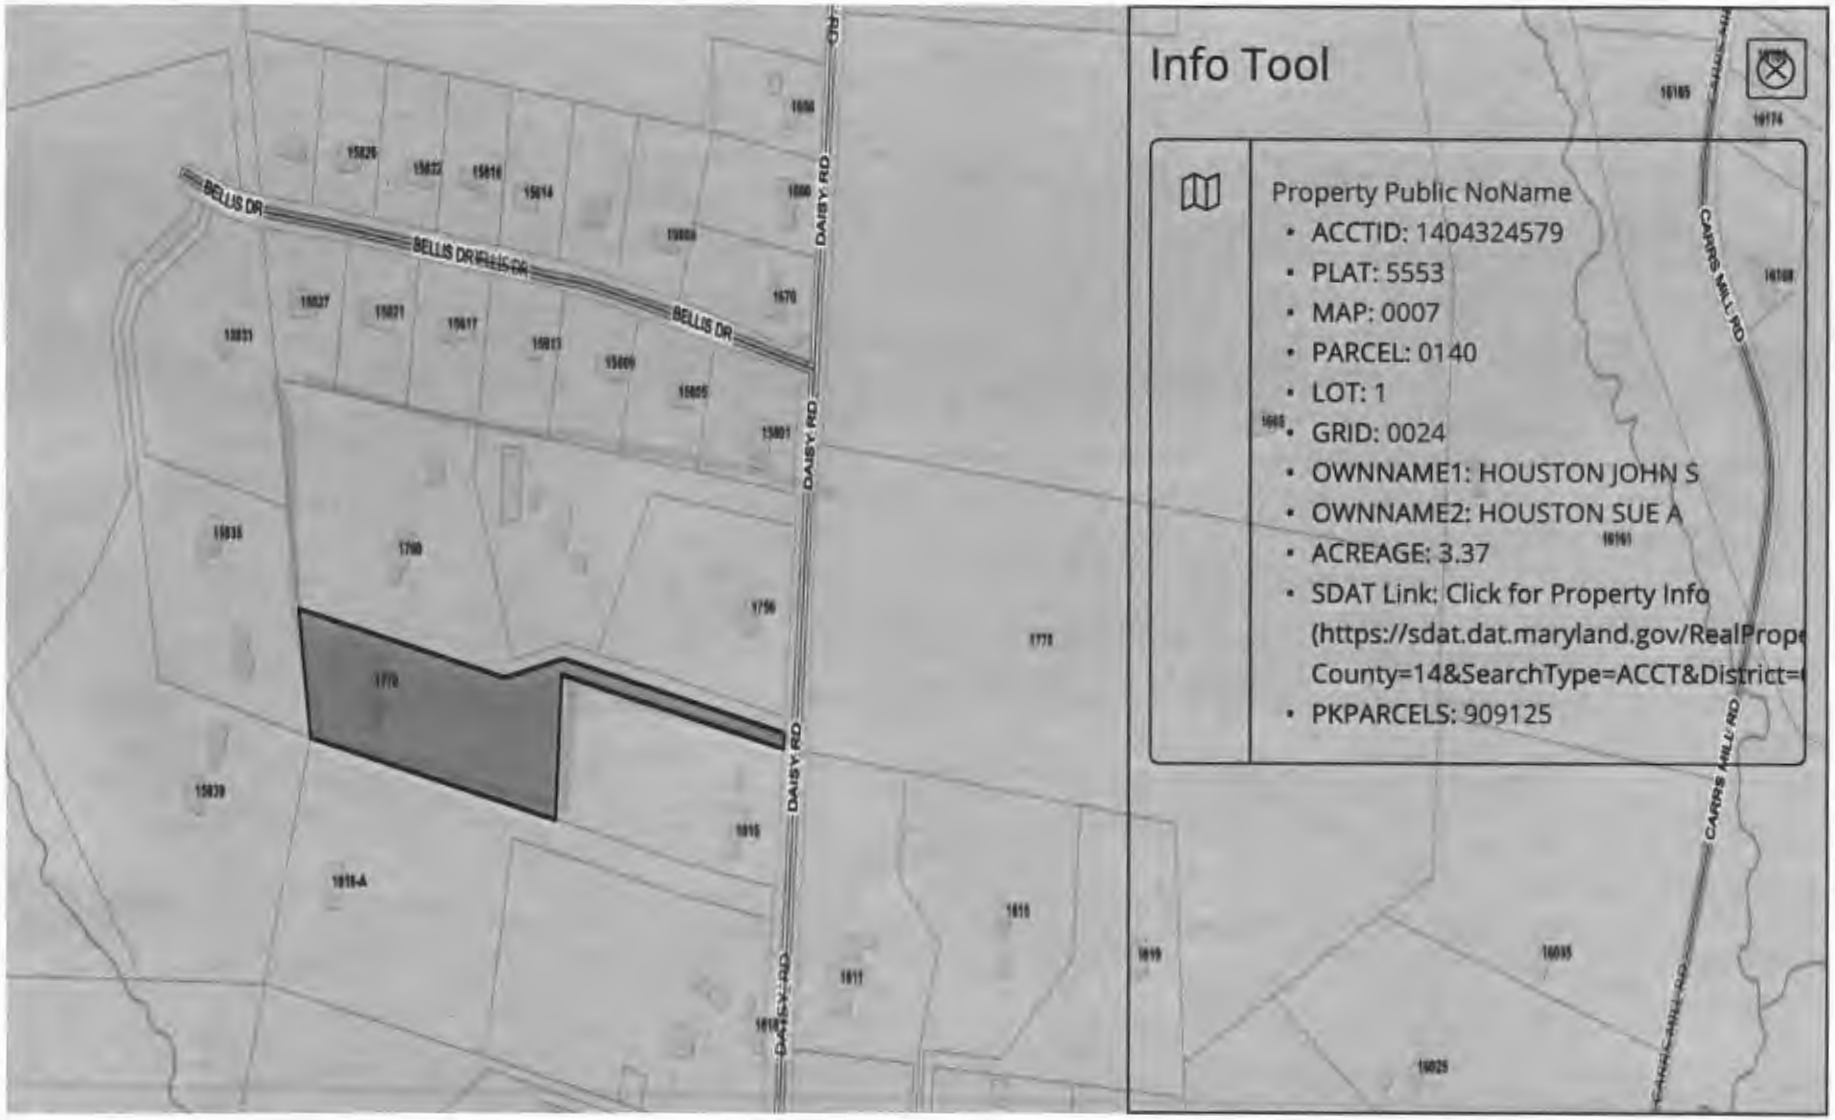
Info Tool
Property Public NoName
• ACCTID: 1404324579
• PLAT: 5553
• MAP: 0007
• PARCEL: 0140
• LOT: 1
• GRID: 0024
• OWNNAME1: HOUSTON JOHN S
• OWNNAME2: HOUSTON SUE A
• ACREAGE: 3.37
• SDAT Link: Click for Property Info
(https://sdat.dat.maryland.gov/RealPrope
County=14&SearchType=ACCT&District=
• PKPARCELS: 909125
BELLIS DR
DAISY RD
CARRS MILL RD


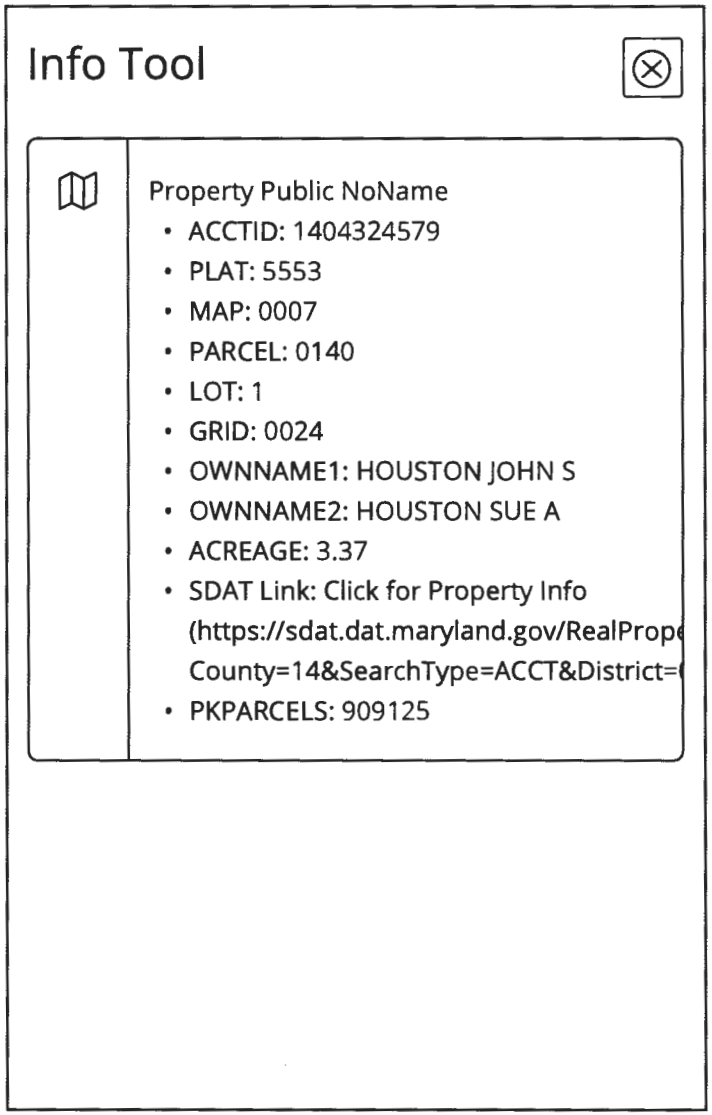

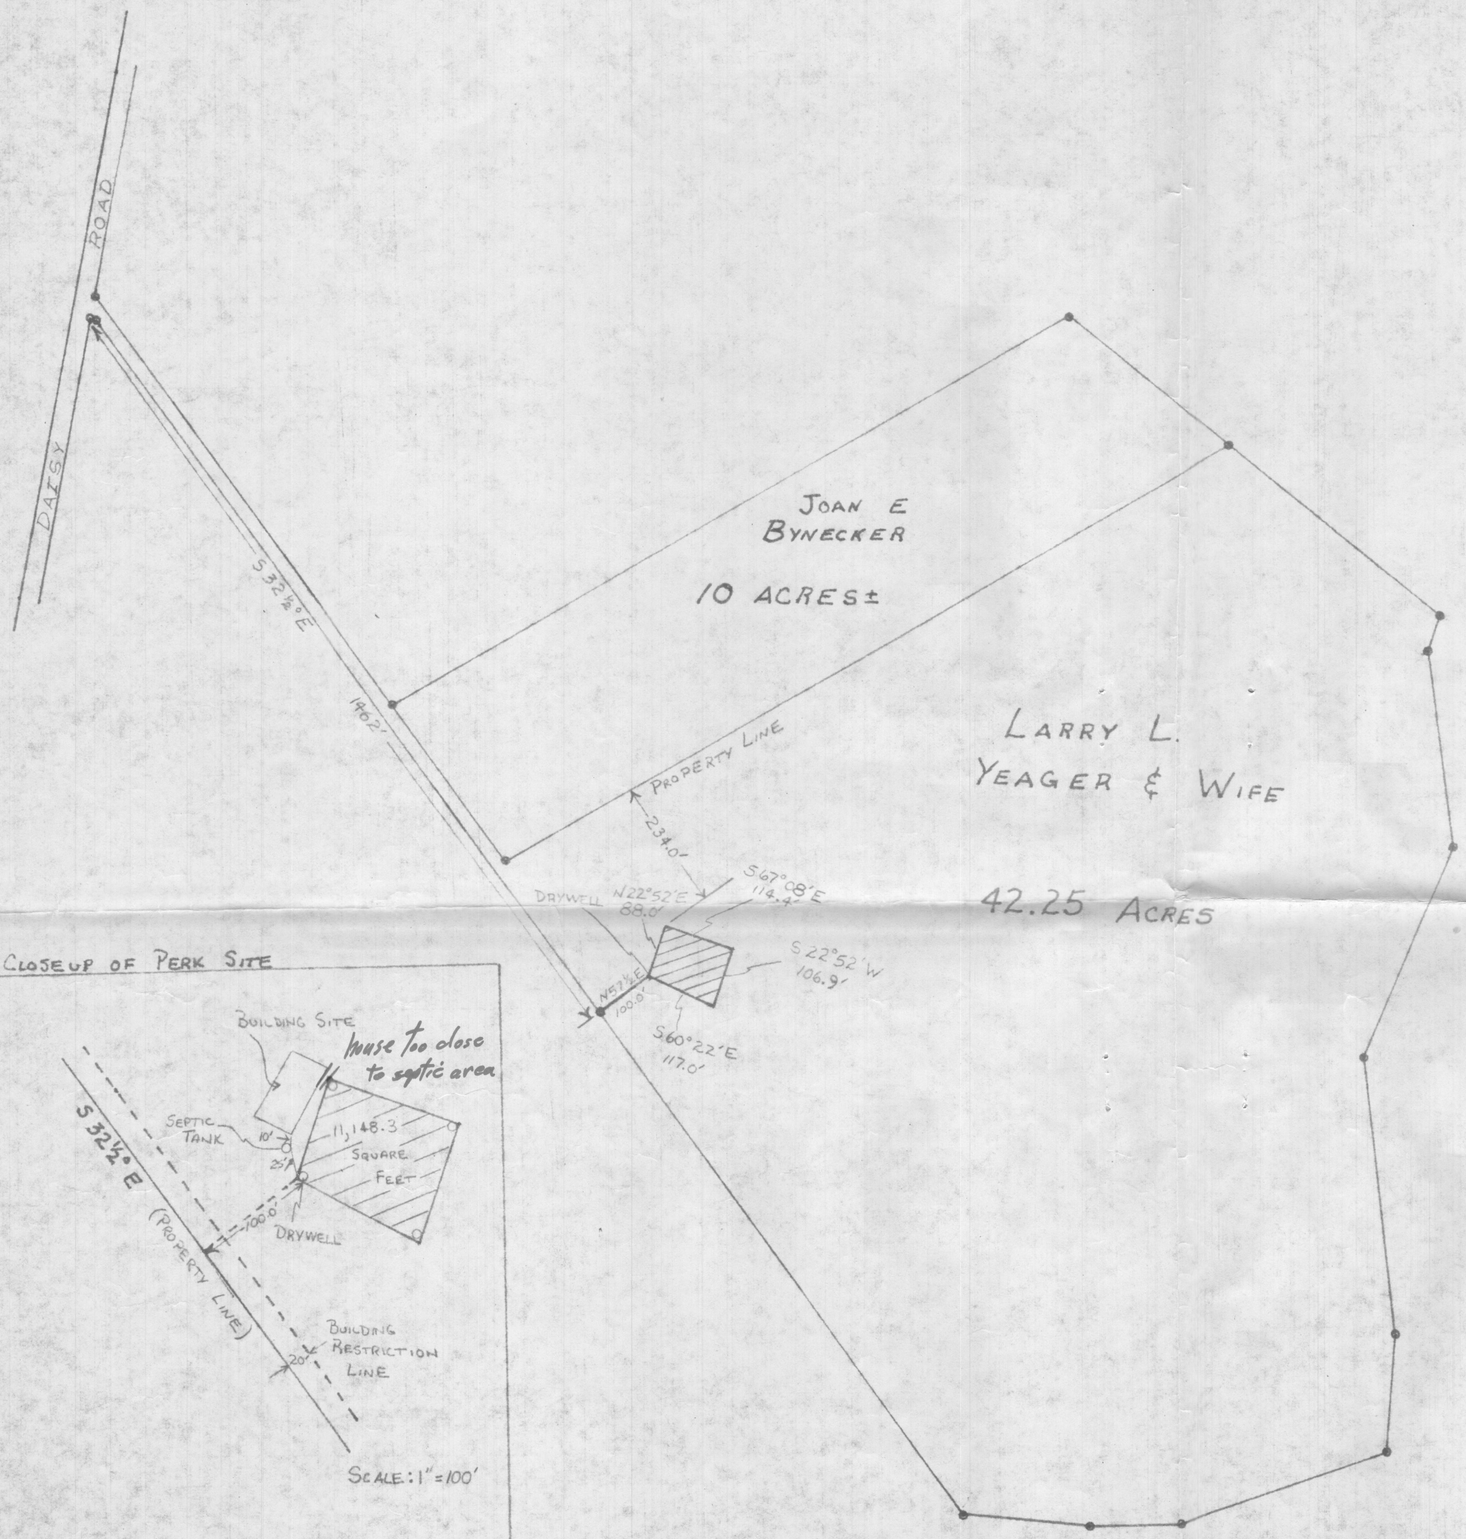

CLOSEUP OF PERK SITE

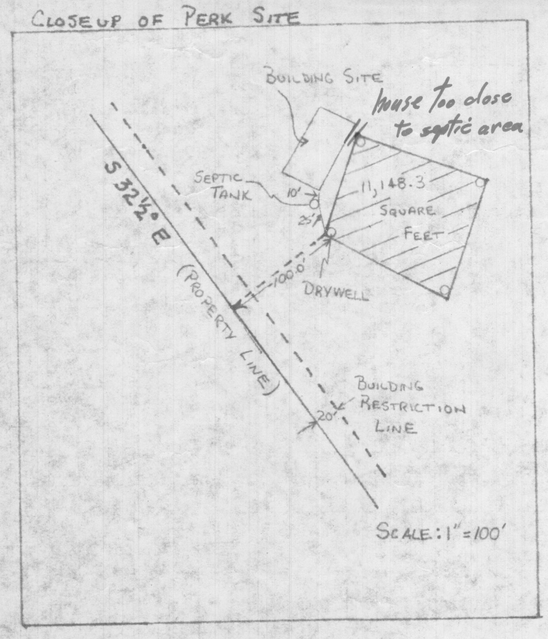

APPROVED BY:

HEALTH OFFICER

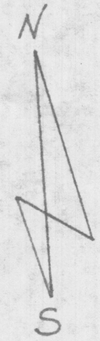

NOTES:

1) ▨ PERK HOLE FIELD LOCATED AS SHOWN. SHADED AREA COMPRISES 11,148.3 FT.² OF SEWAGE DISPOSAL AREA.

2) THIS LOT MEETS THE MINIMUM OWNERSHIP REQUIRMENTS OF THE MD. STATE DEPT. OF HEALTH & MENTAL HYGIENE IN REGUARD TO PRIVATE WATER AND PRIVATE SEWAGE DISPOSAL.

3) INSET SCALE IS DIFFERENT FROM MAIN DRAWING.

4) PERK SITE MEETS ALL SETBACK REGULATIONS

SCALE: 1" = 200 FT.

0 200 400 600 800

I CERTIFY THE ABOVE MEASUREMENTS AND ELEVATIONS ARE ACTUAL & CORRECT FOR THIS PROPERTY

SIGNED: Larry L. Yeager

442-2620

STATE OF MARYLAND · LARRY L. YEAGER · NO. 10078 · REGISTERED PROFESSIONAL ENGINEER