
WATER WELL ABANDONMENT-SEALING REPORT FORM

SUBMIT COPIES OF COMPLETED FORM TO:

- * COUNTY ENVIRONMENTAL AGENCY (contact MDE, WMA if address needed)
- * WELL OWNER
- * MDE, WATER MANAGEMENT ADMINISTRATION, WELL PROGRAM

APPROVED
9/15/2019 (J)

DATE WELL ABANDONED: JULY 31, 2019 (month/day/year)

* PERMIT NUMBER OF ABANDONED WELL (if any)

HO-73-3934

* PERMIT NUMBER OF REPLACEMENT WELL:

* PERSON ABANDONING WELL: Jerry Miller


WELL DRILLER'S LICENSE NUMBER: AWD 060

CIRCLE: MWD / MSD / MGD

* OWNER'S NAME: LARRY TYSON

SITE LOCATION MAP

* WELL LOCATION:
COUNTY: HOWARD
NEAREST TOWN: CLARKSVILLE
TAX MAP BLOCK PARCEL
SUBDIVISION: FOREST HILLS
SECTION: 23
STREET ADDRESS: 11850 TALL TIMBER DR

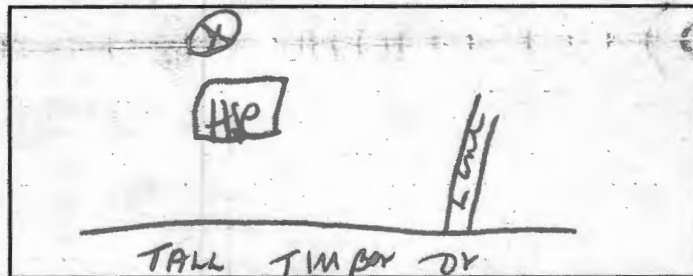

LATITUDE 39.207193

LONGITUDE 76.921952

LOG OF SEALING MATERIAL

* TYPE OF WELL BEING ABANDONED:
☒ DRILLED ☐ JETTED
☐ BORED ☐ HAND DUG
☐ OTHER (specify) _____

* USE CODE:
☒ DOMESTIC ☐ MUNICIPAL/PUBLIC
☐ IRRIGATION ☐ INDUSTRIAL
☐ TEST/OBSERVATION ☐ GEOTHERMAL

* TYPE OF CASING:
☒ STEEL ☐ PLASTIC
☐ CONCRETE ☐ OTHER (specify) _____

MATERIAL	FEET	
	FROM	TO
Bentonite	96	3
To be excavated out	3	0
VOLUME OF MATERIAL USED		
450 # mixed AS slurry		

SIZE OF CASING: 6 INCHES IN DIAMETER

DEPTH OF WELL: 96 FEET DEEP

WAS ANY CASING REMOVED? YES ☒ NO

If yes, length removed, in feet: _____

WAS CASING RIPPED OR PERFORATED? YES ☒ NO

George F. Hartenbury 040
SIGNATURE-MASTER WELL DRILLER OR SUPERVISING SANITARIAN LICENSE#

MWD / MSD / MGS
CIRCLE ONE

7-31-19
DATE

COUNTY

Pursuant to § 10-624 of the State Govt. Article of the Maryland Code, personal info requested on this form is used in processing this form pursuant to COMAR 26.04.04. Failure to provide the info may result in this form not being processed. You have the right to inspect, amend, or correct this form. The Maryland Department of the Environment is subject to the Maryland Public Information Act. This form may be made available on the Internet via MDE's website and is subject to inspection or copying, in whole or in part, by the public and other governmental agencies, if not protected by federal or State Law.