C 1 | 0797 | SEQUENCE NO. (MDE USE ONLY)

1 2 3 6
(THIS NUMBER IS TO BE PUNCHED IN COLS. 3-6 ON ALL CARDS)

STATE OF MARYLAND
WELL COMPLETION REPORT
FILL IN THIS FORM COMPLETELY
PLEASE TYPE

THIS REPORT MUST BE SUBMITTED WITHIN 45 DAYS AFTER WELL IS COMPLETED.

COUNTY NUMBER (13) A513567E

ST/CO USE ONLY
DATE Received MM DD YY
8 13

DATE WELL COMPLETED MM 08 DD 25 YY 03
15 20

Depth of Well 180 (TO NEAREST FOOT)
22 26

OW SRC 11/7/03

PERMIT NO. FROM "PERMIT TO DRILL WELL" AA-94-3718
28 29 30 31 32 33 34 35 36 37

OWNER (last name) NORTHRIDGE DEVELOPMENT (first name)
STREET OR RFD FOX STREAM WAY TOWN GLENELG
SUBDIVISION FOX MEADOWS SECTION LOT B7

WELL LOG
Not required for driven wells

STATE THE KIND OF FORMATIONS PENETRATED, THEIR COLOR, DEPTH, THICKNESS AND IF WATER BEARING

DESCRIPTION (Use additional sheets if needed)	FEET FROM	FEET TO	check if water bearing
Top Soil	0	2	
Sandy	2	45	W
Sand Stone	45	50	
MICKA 1	50	80	
Sand Stone	80	85	W
MICKA 3	85	180	

NUMBER OF UNSUCCESSFUL WELLS: 0

WELL HYDROFRACTURED yes (Y) no (N)

CIRCLE APPROPRIATE LETTER
- A A WELL WAS ABANDONED AND SEALED WHEN THIS WELL WAS COMPLETED
- E ELECTRIC LOG OBTAINED
- P TEST WELL CONVERTED TO PRODUCTION WELL

I HEREBY CERTIFY THAT THIS WELL HAS BEEN CONSTRUCTED IN ACCORDANCE WITH COMAR 26.04.04 "WELL CONSTRUCTION" AND IN CONFORMANCE WITH ALL CONDITIONS STATED IN THE ABOVE CAPTIONED PERMIT, AND THAT THE INFORMATION PRESENTED HEREIN IS ACCURATE AND COMPLETE TO THE BEST OF MY KNOWLEDGE.

DRILLERS LIC. NO. M SD 112
DRILLERS SIGNATURE
(MUST MATCH SIGNATURE ON APPLICATION)

LIC. NO. M D

SITE SUPERVISOR (sign. of driller or journeyman responsible for sitework if different from permittee)

GROUTING RECORD
WELL HAS BEEN GROUTED (Circle Appropriate Box) yes (Y) 44 no (N) 44

TYPE OF GROUTING MATERIAL (Circle one)
CEMENT (CM) BENTONITE CLAY (BC)
NO. OF BAGS 19 NO. OF POUNDS 1580
GALLONS OF WATER 114
DEPTH OF GROUT SEAL (to nearest foot)
from 0 (TOP) 48 52 ft. to 30 (BOTTOM) 54 58 ft.
(enter 0 if from surface)

CASING RECORD
casing types insert appropriate code below
(ST) STEEL (CO) CONCRETE (PL) PLASTIC (OT) OTHER

MAIN CASING TYPE	Nominal diameter top (main) casing (nearest inch)	Total depth of main casing (nearest foot)
PL	6	60
60 61	63 64	66 70

OTHER CASING (if used)

EACH CASING	diameter inch	depth (feet) from	to

SCREEN RECORD
screen type or open hole insert appropriate code below
(ST) STEEL (BR) BRASS BRONZE (HO) OPEN HOLE (PL) PLASTIC (OT) OTHER

C 2

DEPTH (nearest ft.)

EACH SCREEN			
1	80	58	180
2			
3			

SLOT SIZE 1 ____ 2 ____ 3 ____

DIAMETER OF SCREEN ____ (NEAREST INCH)
56 60

GRAVEL PACK IF WELL DRILLED WAS FLOWING WELL INSERT F IN BOX 68	from	to
		68

MDE USE ONLY
(NOT TO BE FILLED IN BY DRILLER)
T (E.R.O.S.) W Q
70 72 74 75 76
TELESCOPE CASING | LOG INDICATOR | OTHER DATA

C 3

PUMPING TEST
HOURS PUMPED (nearest hour) 3 (8 9)
PUMPING RATE (gal. per min.) 10 (11 15)
METHOD USED TO MEASURE PUMPING RATE Bucket
WATER LEVEL (distance from land surface)
BEFORE PUMPING 32 (17 20) ft.
WHEN PUMPING 52 (22 25) ft.

TYPE OF PUMP USED (for test)
(A) air (P) piston (T) turbine (C) centrifugal (R) rotary (O) other (describe below) (J) jet (S) submersible

PUMP INSTALLED
DRILLER INSTALLED PUMP (CIRCLE) (YES or NO) YES (NO)
IF DRILLER INSTALLS PUMP, THIS SECTION MUST BE COMPLETED FOR ALL WELLS.
TYPE OF PUMP INSTALLED PLACE (A,C,J,P,R,S,T,O) IN BOX 29. 29
CAPACITY: GALLONS PER MINUTE (to nearest gallon) 31 35
PUMP HORSE POWER 37 41
PUMP COLUMN LENGTH (nearest ft.) 43 47
CASING HEIGHT (circle appropriate box and enter casing height)
(+) above (–) below 49
LAND SURFACE 2 (nearest foot) 50 51

LOCATION OF WELL ON LOT
SHOW PERMANENT STRUCTURE SUCH AS BUILDING, SEPTIC TANKS, AND /OR LANDMARKS AND INDICATE NOT LESS THAN TWO DISTANCES (MEASUREMENTS TO WELL)

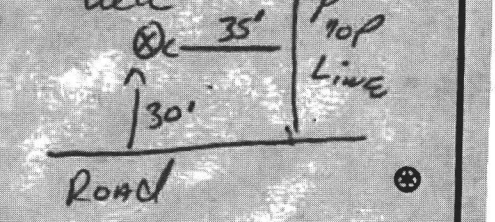

DENV-CR97

COUNTY