

\*\*\*\*\*  
WATER WELL ABANDONMENT-SEALING REPORT FORM  
\*\*\*\*\*

SUBMIT COPIES OF COMPLETED FORM TO:

- \* COUNTY ENVIRONMENTAL AGENCY (contact MDE, WMA if address needed)
- \* WELL OWNER
- \* MDE, WATER MANAGEMENT ADMINISTRATION, WELL PROGRAM

DATE WELL ABANDONED: 7/27/2020 (month/day/year)

\* PERMIT NUMBER OF ABANDONED WELL (if any)

\* PERMIT NUMBER OF REPLACEMENT WELL:


\* PERSON ABANDONING WELL: ROBERT COPSEY

WELL DRILLER'S LICENSE NUMBER: 161

CIRCLE: MWD/MSD/MGD

\* OWNER'S NAME: Sophia MANAKOS

SITE LOCATION MAP

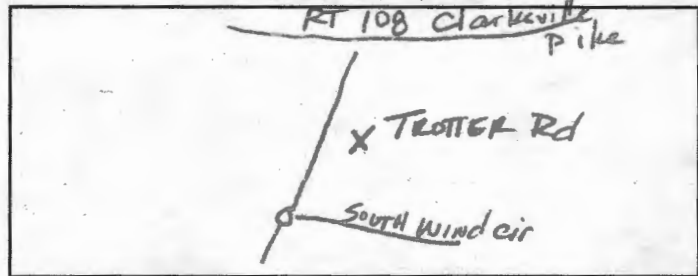

\* WELL LOCATION:

COUNTY: HOWARD CO

NEAREST TOWN: CLARKSVILLE

TAX MAP 0035 BLOCK \_\_\_\_\_ PARCEL 0180

SUBDIVISION: 3002

SECTION: \_\_\_\_\_ LOT: 63

STREET ADDRESS: 5645 TROTTER ROAD

LATITUDE 3 9.125906

LONGITUDE 7 6.551412

LOG OF SEALING MATERIAL

MATERIAL	FEET	
	FROM	TO
<u>Bentonite clay</u>	<u>200</u>	<u>5</u>
<u>clean fill</u>	<u>5</u>	<u>0</u>
VOLUME OF MATERIAL USED		

\* TYPE OF WELL BEING ABANDONED:

- DRILLED  JETTED
- BORED  HAND DUG
- OTHER (specify) \_\_\_\_\_

\* USE CODE:

- DOMESTIC  MUNICIPAL/PUBLIC
- IRRIGATION  INDUSTRIAL
- TEST/OBSERVATION  GEOTHERMAL

\* TYPE OF CASING:

- STEEL  PLASTIC
- CONCRETE  OTHER (specify) \_\_\_\_\_

SIZE OF CASING: 6" INCHES IN DIAMETER

DEPTH OF WELL: 200 FEET DEEP

WAS ANY CASING REMOVED?  YES  NO

If yes, length removed, in feet: 5

WAS CASING RIPPED OR PERFORATED?  YES  NO

SIGNATURE-MASTER WELL DRILLER OR SUPERVISING SANITARIAN LICENSE# Robert Copsey 161

MWD/MSD/MGS CIRCLE ONE

7/27/20 DATE

COUNTY

Pursuant to § 10-624 of the State Govt. Article of the Maryland Code, personal info requested on this form is used in processing this form pursuant to COMAR 26.04.04. Failure to provide the info may result in this form not being processed. You have the right to inspect, amend, or correct this form. The Maryland Department of the Environment is subject to the Maryland Public Information Act. This form may be made available on the Internet via MDE's website and is subject to inspection or copying, in whole or in part, by the public and other governmental agencies, if not protected by federal or State Law.