
WATER WELL ABANDONMENT-SEALING REPORT FORM

SUBMIT COPIES OF COMPLETED FORM TO:

- * COUNTY ENVIRONMENTAL AGENCY (contact MDE, WMA if address needed)
- * WELL OWNER
- * MDE, WATER MANAGEMENT ADMINISTRATION, WELL PROGRAM

DATE WELL ABANDONED: 1-12-19 (month/day/year)

* PERMIT NUMBER OF ABANDONED WELL (if any) _____

* PERMIT NUMBER OF REPLACEMENT WELL: _____

* PERSON ABANDONING WELL: William Gizzardi

WELL DRILLER'S LICENSE NUMBER: 233


* OWNER'S NAME: Viking Custom Homes

CIRCLE: MWD MSD MGD

* WELL LOCATION:

SITE LOCATION MAP

COUNTY: Howard
NEAREST TOWN: Fellish City
TAX MAP 22 BLOCK 6 PARCEL 582
SUBDIVISION: Woods at Trindalphia
SECTION: _____ LOT: 1
STREET ADDRESS: 12510 Trindalphia

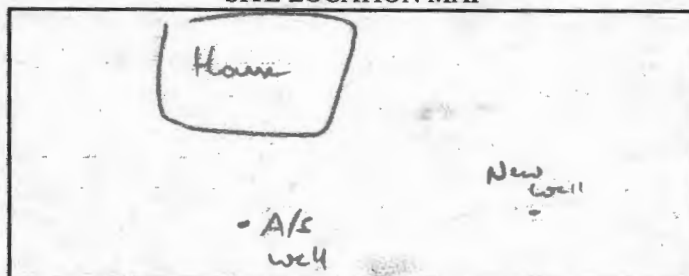

LATITUDE 39.277994

LONGITUDE 76.945481

LOG OF SEALING MATERIAL

MATERIAL	FEET	
	FROM	TO
Bentonite	280	10
Pontlunel	10	5
Dirt	5	0

* TYPE OF WELL BEING ABANDONED:

☒ DRILLED ☐ JETTED
☐ BORED ☐ HAND DUG
☐ OTHER (specify) _____

* USE CODE:

☒ DOMESTIC ☐ MUNICIPAL/PUBLIC
☐ IRRIGATION ☐ INDUSTRIAL
☐ TEST/OBSERVATION ☐ GEOTHERMAL

* TYPE OF CASING:

☒ STEEL ☐ PLASTIC
☐ CONCRETE ☐ OTHER (specify) _____

VOLUME OF MATERIAL USED

Bentonite (2 bags) 18 bags, Pontlunel (2 bags)

SIZE OF CASING: 6 INCHES IN DIAMETER

DEPTH OF WELL: 280 FEET DEEP

WAS ANY CASING REMOVED? ☒ YES ☐ NO

If yes, length removed, in feet: 3

WAS CASING RIPPED OR PERFORATED? ☐ YES ☒ NO

SIGNATURE William Gizzardi 233
MASTER WELL DRILLER OR SUPERVISING SANITARIAN LICENSE#

MWD MSD MGS
CIRCLE ONE

12/31/19
DATE

COUNTY

Pursuant to § 10-624 of the State Govt. Article of the Maryland Code, personal info requested on this form is used in processing this form pursuant to COMAR 26.04.04. Failure to provide the info may result in this form not being processed. You have the right to inspect, amend, or correct this form. The Maryland Department of the Environment is subject to the Maryland Public Information Act. This form may be made available on the Internet via MDE's website and is subject to inspection or copying, in whole or in part, by the public and other governmental agencies, if not protected by federal or State Law.