

MARYLAND DEPARTMENT OF THE ENVIRONMENT, WATER MANAGEMENT ADMINISTRATION
1800 Washington Blvd., Baltimore, Maryland 21230 (410) 537-3784

WATER WELL ABANDONMENT-SEALING REPORT FORM

SUBMIT COPIES OF COMPLETED FORM TO:

- * COUNTY ENVIRONMENTAL AGENCY (contact MDE, WMA if address needed)
- * WELL OWNER
- * MDE, WATER MANAGEMENT ADMINISTRATION, WELL PROGRAM

DATE WELL ABANDONED: 01-22-2021 (month/day/year)

* PERMIT NUMBER OF ABANDONED WELL (if any)

* PERMIT NUMBER OF REPLACEMENT WELL:


* PERSON ABANDONING WELL: Robert Moller WELL DRILLER'S LICENSE NUMBER: AND-063

CIRCLE: MWD / MSD / MGD

* OWNER'S NAME: Neil Terry Peters / Mary E. Trustee

* WELL LOCATION:

SITE LOCATION MAP

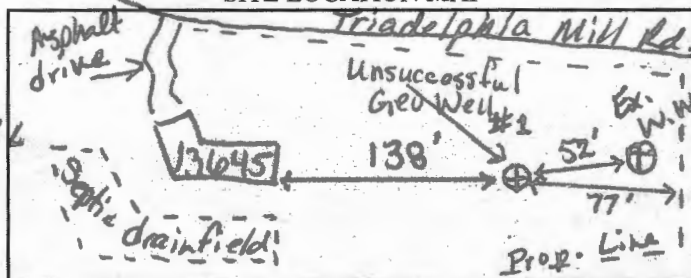

COUNTY: Howard
NEAREST TOWN: Dayton
TAX MAP 6034 BLOCK PARCEL 0001
SUBDIVISION: Lot 27 3.17 Ac. Duffrethen Estates R5B4
SECTION: 27 LOT: 27
STREET ADDRESS: 13645 Triadelphia Mill Rd.

LATITUDE 3 9.215207

LONGITUDE 7 6.985995

LOG OF SEALING MATERIAL

MATERIAL	FEET	
	FROM	TO
Bentonite Grout (well grout dt)	0	50
VOLUME OF MATERIAL USED		
130 gal.		

* TYPE OF WELL BEING ABANDONED:

☐ DRILLED ☐ JETTED
☐ BORED ☐ HAND DUG
☒ OTHER (specify) Air Rotary

* USE CODE:

☐ DOMESTIC ☐ MUNICIPAL/PUBLIC
☐ IRRIGATION ☐ INDUSTRIAL
☐ TEST/OBSERVATION ☒ GEOTHERMAL

* TYPE OF CASING:

☐ STEEL ☒ PLASTIC
☐ CONCRETE ☐ OTHER (specify)

SIZE OF CASING: 6 INCHES IN DIAMETER

DEPTH OF WELL: 50 FEET DEEP

WAS ANY CASING REMOVED? ☒ YES ☐ NO

If yes, length removed, in feet: 50

WAS CASING RIPPED OR PERFORATED? ☐ YES ☒ NO

Stephen DeLoach 587
SIGNATURE-MASTER WELL DRILLER OR SUPERVISING SANITARIAN LICENSE#

MWD MSD / MGS
CIRCLE ONE

01-22-21
DATE

COUNTY

Pursuant to § 10-624 of the State Govt. Article of the Maryland Code, personal info requested on this form is used in processing this form pursuant to COMAR 26.04.04. Failure to provide the info may result in this form not being processed. You have the right to inspect, amend, or correct this form. The Maryland Department of the Environment is subject to the Maryland Public Information Act. This form may be made available on the Internet via MDE's website and is subject to inspection or copying, in whole or in part, by the public and other governmental agencies, if not protected by federal or State Law.