

MARYLAND DEPARTMENT OF THE ENVIRONMENT, WATER MANAGEMENT ADMINISTRATION

1800 Washington Blvd., Baltimore, Maryland 21230 (410) 537-3784

WATER WELL ABANDONMENT-SEALING REPORT FORM

SUBMIT COPIES OF COMPLETED FORM TO:

- * COUNTY ENVIRONMENTAL AGENCY (contact MDE, WMA if address needed)
- * WELL OWNER
- * MDE, WATER MANAGEMENT ADMINISTRATION, WELL PROGRAM

DATE WELL ABANDONED: 8-12-20 (month/day/year)

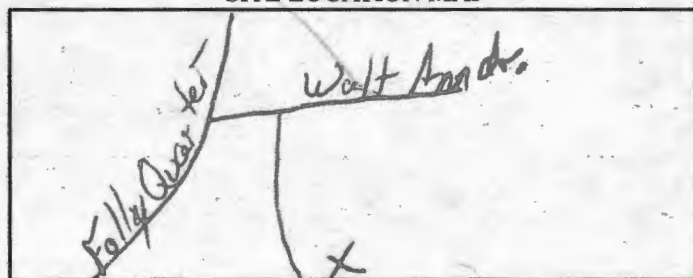
* PERMIT NUMBER OF ABANDONED WELL (if any) _____

* PERMIT NUMBER OF REPLACEMENT WELL: _____

* PERSON ABANDONING WELL: Andrew HousenWELL DRILLER'S LICENSE NUMBER: 224CIRCLE: MWD / MSD / MGD* OWNER'S NAME: Tori Paule

SITE LOCATION MAP

* WELL LOCATION:
 COUNTY: Howard
 NEAREST TOWN: Ellicott City
 TAX MAP 0022 BLOCK 0015 PARCEL 0115
 SUBDIVISION: _____
 SECTION: _____ LOT: 2
 STREET ADDRESS: 3921 Walt Ann

LATITUDE 3 9.261478LONGITUDE 7 6.968425

LOG OF SEALING MATERIAL

MATERIAL	FEET	
	FROM	TO
Cement	7	5
AB. PERMIT FOR POOLHOUSE 626003718 PREVIOUSLY FILLED IN STONE - DRIVER VOLUME OF MATERIAL USED Cement 470/65 w/ CEMENT		

* TYPE OF WELL BEING ABANDONED:

☐ DRILLED ☐ JETTED
☐ BORED ☒ HAND DUG
☐ OTHER (specify) _____

* USE CODE:

☒ DOMESTIC ☐ MUNICIPAL/PUBLIC
☐ IRRIGATION ☐ INDUSTRIAL
☐ TEST/OBSERVATION ☐ GEOTHERMAL

* TYPE OF CASING:

☐ STEEL ☐ PLASTIC
☒ CONCRETE ☐ OTHER (specify) _____

SIZE OF CASING: 36 INCHES IN DIAMETERDEPTH OF WELL: _____ FEET DEEP total depth unknownWAS ANY CASING REMOVED? YES ☒ NO ☐

If yes, length removed, in feet: _____

WAS CASING RIPPED OR PERFORATED? YES ☒ NO ☐SIGNATURE-MASTER WELL DRILLER OR SUPERVISING SANITARIAN Andrew Housen LICENSE# 224CIRCLE ONE MWD / MSD / MGSDATE 8-12-20

COUNTY

Pursuant to § 10-624 of the State Govt. Article of the Maryland Code, personal info requested on this form is used in processing this form pursuant to COMAR 26.04.04. Failure to provide the info may result in this form not being processed. You have the right to inspect, amend, or correct this form. The Maryland Department of the Environment is subject to the Maryland Public Information Act. This form may be made available on the Internet via MDE's website and is subject to inspection or copying, in whole or in part, by the public and other governmental agencies, if not protected by federal or State Law.