APPLICATION

A 32807

SEWAGE DISPOSAL TESTING

STATE OF MARYLAND - DEPARTMENT OF HEALTH AND MENTAL HYGIENE

P _____

HOWARD COUNTY HEALTH DEPARTMENT
ENVIRONMENTAL HEALTH SERVICES
P. O. BOX 476 ELLICOTT CITY, MARYLAND 21043
TELEPHONE: 992-2330

6/10/83
9:30AM.

DISTRICT 3rd

DATE 5/26/83

TO: THE COUNTY HEALTH OFFICER
ELLICOTT CITY, MARYLAND

I, HEREBY, APPLY FOR THE NECESSARY TEST IN ORDER TO CONSTRUCT (OR RECONSTRUCT) A SEWAGE DISPOSAL SYSTEM.

PROPERTY OWNER JOEL ABRAMSON (JOHN S. FITZGERALD - CONTRACT BUYER)

ADDRESS 13501 TURKEY BRANCH PKWY. ROCKVILLE, MD. 20853 PHONE 301-587-6965 (W) 301-933-7606 (H)

PROPERTY LOCATION:

SUBDIVISION TRIDELPHIA FARMS I LOT NO. 2

ROAD AND DESCRIPTION PRIVATE DRIVE ACROSS WALT ANN RD

SIZE OF LOT 5.056 ACRES TYPE BLDG. SINGLE FAMILY (NUMBER OF BEDROOMS)

THE SYSTEM INSTALLED UNDER THIS APPLICATION IS ACCEPTABLE ONLY UNTIL PUBLIC FACILITIES BECOME AVAILABLE. I FULLY UNDERSTAND THE FEE CONNECTED WITH THE FILING OF THIS PERC TEST APPLICATION IS NON-REFUNDABLE UNDER ANY CIRCUMSTANCES. I ALSO AGREE TO COMPLY WITH ALL M.O.S.H.A. REQUIREMENTS IN TESTING THIS LOT. X John S. Fitzgerald (SIGNATURE OF APPLICANT)

APPROVED BY C Williams FOR TRENCHES DATE 6-10-83

REJECTED BY _____ FOR _____ DATE _____

HOLD PENDING FURTHER TESTS C Williams DATE _____

REASONS FOR REJECTION OR HOLDING _____

THIS IS NOT A PERMIT

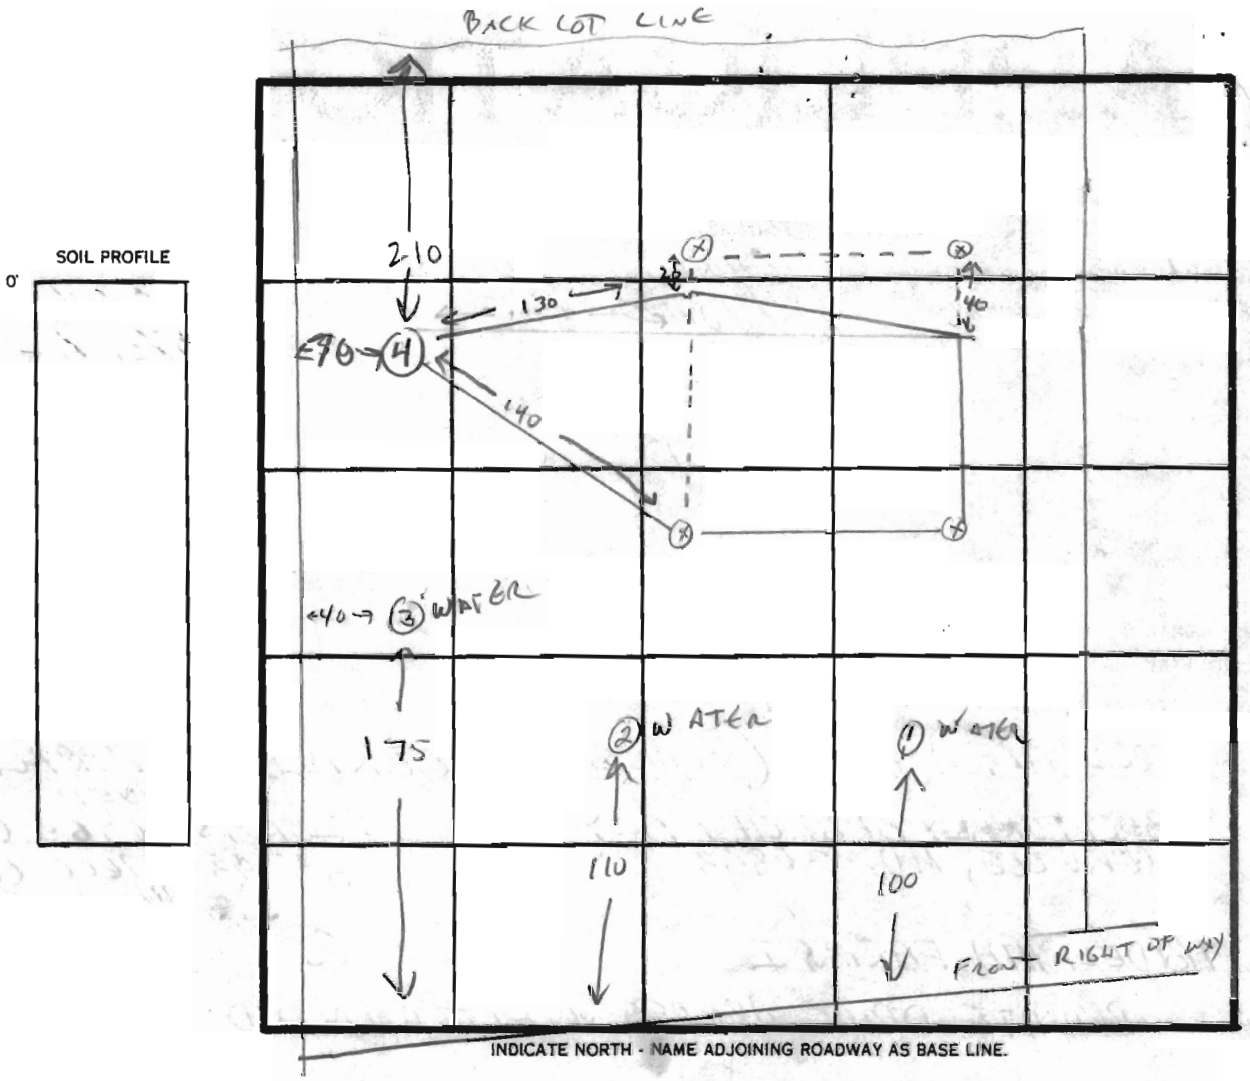

INDICATE NORTH - NAME ADJOINING ROADWAY AS BASE LINE.

DATE	TEST NO.	DEPTH	PRE-WET START	PRE-WET STOP	TEST - 1" DROP START	TEST - 1" DROP STOP	TIME
6-10-83	1 & 2	7'	WATER				
6-10-83	3	8'	WATER				
	4	4 8'	11:20 11:20	11:25 11:24	11:25 11:24	11:32 11:29	7 MIN 5 MIN
		12'	MICA - SAND		DRY		

REMARKS BASEMENT FIXTURES OK IF HOUSE IS SUFFICIENTLY ELEVATED 6-10-83 C

TYPE OF SOIL MICA SAND

TESTED BY C Williams ALSO PRESENT PAT LENDRIM JOHN FITZGERALD

EH-12-1079