C 1 65744
1 2 3 6
(THIS NUMBER IS TO BE PUNCHED IN COLS. 3-6 ON ALL CARDS)

SEQUENCE NO. (MDE USE ONLY)

STATE OF MARYLAND
WELL COMPLETION REPORT

FILL IN THIS FORM COMPLETELY
PLEASE TYPE #1

THIS REPORT MUST BE SUBMITTED WITHIN 45 DAYS AFTER WELL IS COMPLETED.

COUNTY NUMBER 13

ST/CO USE ONLY
DATE Received MM DD YY 01 26 22 (8–13)

DATE WELL COMPLETED MM 10 DD 22 YY 2021 (15–20)

Approved 1/28/22 ST

Depth of Well 320' (TO NEAREST FOOT) (22–26)

PERMIT NO. FROM "PERMIT TO DRILL WELL" HO-20-0138 (28 29 30 31 32 33 34 35 36 37)

OWNER Porko (last name) Stephen (first name)
WELL SITE ADDRESS 6731 Cortina Drive TOWN Highland.
SUBDIVISION Lot 15 1,002A, 6731 Cortina Dr. SECTION ______ LOT 15

WELL LOG

Not required for driven wells

STATE THE KIND OF FORMATIONS PENETRATED, THEIR COLOR, DEPTH, THICKNESS AND IF WATER BEARING

DESCRIPTION (Use additional sheets if needed)	FEET FROM	FEET TO	check if water bearing
Si H. brown, mica dry frac fine Sand.	0'	45'	
weathered Rock gray.	45'	60'	✓
weathered Rock gray Wissahickon Formation lower pelitic Schist.	60'	320'	✓
Installed 1.25" X 320' HDPE U-Bend loop			

NUMBER OF UNSUCCESSFUL WELLS: 0

WELL HYDROFRACTURED yes ☐ Y no ☒ N

CIRCLE APPROPRIATE LETTER
- **A** A WELL WAS ABANDONED AND SEALED WHEN THIS WELL WAS COMPLETED
- **E** ELECTRIC LOG OBTAINED
- **P** TEST WELL CONVERTED TO PRODUCTION WELL

I HEREBY CERTIFY THAT THIS WELL HAS BEEN CONSTRUCTED IN ACCORDANCE WITH COMAR 26.04.04 "WELL CONSTRUCTION" AND IN CONFORMANCE WITH ALL CONDITIONS STATED IN THE ABOVE CAPTIONED PERMIT, AND THAT THE INFORMATION PRESENTED HEREIN IS ACCURATE AND COMPLETE TO THE BEST OF MY KNOWLEDGE.

DRILLERS LIC. NO. M W D 5 8 7
DRILLERS SIGNATURE (MUST MATCH SIGNATURE ON APPLICATION)

LIC. NO. A W D 0 6 3

SITE SUPERVISOR (sign. of driller or journeyman responsible for sitework if different from permittee)

GROUTING RECORD

[illegible]

WELL HAS BEEN GROUTED (Circle Appropriate Box) yes ☒ Y (44) no ☐ N (44)

TYPE OF GROUTING MATERIAL (Circle one)
CEMENT ☐ CM (45 46) BENTONITE CLAY ☒ BC (45 46)

NO. OF BAGS 10 NO. OF POUNDS 500
GALLONS OF WATER 190
DEPTH OF GROUT SEAL (to nearest foot)
from 0' ft. (48 TOP 52) to 320' ft. (54 BOTTOM 58)
(enter 0 if from surface)

CASING RECORD

casing types insert appropriate code below

☐ ST STEEL ☐ CO CONCRETE
☒ PL PLASTIC ☐ OT OTHER

MAIN CASING TYPE	Nominal diameter top (main) casing (nearest inch)!	Total depth of main casing (nearest foot)
PL (60 61)	6" (63 64)	60' (66–70)

OTHER CASING (if used)

EACH CASING

	diameter inch	depth (feet) from	to

SCREEN RECORD

screen type or open hole insert appropriate code below

☐ ST STEEL ☐ BR BRASS BRONZE ☒ HO OPEN HOLE
☐ PL PLASTIC ☐ OT OTHER

C 2
1 2

EACH SCREEN

		DEPTH (nearest ft.)	
1	HO (8 9)	60 (11–15)	320 (17–21)
2	(23 24)	(26–30)	(32–36)
3	(38 39)	(41–45)	(47–51)

SLOT SIZE 1 ______ 2 ______ 3 ______

DIAMETER OF SCREEN ______ (56–60) (NEAREST INCH)

GRAVEL PACK from ______ to ______
IF WELL DRILLED WAS FLOWING WELL INSERT F IN BOX 68

MDE USE ONLY (NOT TO BE FILLED IN BY DRILLER)
T (E.R.O.S.) W Q
70 ___ TELESCOPE CASING
72 ___ LOG INDICATOR
74 75 76 OTHER DATA

C 3
1 2

PUMPING TEST

HOURS PUMPED (nearest hour) N/A (8 9)
PUMPING RATE (gal. per min.) N/A (11–15)
METHOD USED TO MEASURE PUMPING RATE N/A
WATER LEVEL (distance from land surface)
BEFORE PUMPING N/A ft. (17–20)
WHEN PUMPING N/A ft. (22–25)

TYPE OF PUMP USED (for test)
- ☐ A air (27)
- ☐ P piston (27)
- ☐ T turbine (27)
- ☐ C centrifugal (27)
- ☐ R rotary (27)
- ☐ O other (describe below) (27)
- ☐ J jet (27)
- ☐ S submersible (27)

PUMP INSTALLED

DRILLER INSTALLED PUMP (CIRCLE) (YES or NO) YES [✓ NO]

IF DRILLER INSTALLS PUMP, THIS SECTION MUST BE COMPLETED FOR ALL WELLS.

TYPE OF PUMP INSTALLED PLACE (A,C,J,P,R,S,T,O) IN BOX 29. N/A (29)
CAPACITY: GALLONS PER MINUTE (to nearest gallon) N/A (31–35)
PUMP HORSE POWER N/A (37–41)
PUMP COLUMN LENGTH (nearest ft.) N/A (43–47)

CASING HEIGHT (circle appropriate box and enter casing height)
☐ + above (49)
☒ − below (49)
LAND SURFACE -3 (nearest foot) (50 51)

LATITUDE 39.186044
LONGITUDE 76.987453
(DEFAULT COORD. WGS 84)

Pursuant to §10-624 of the State Govt. Article of the Maryand Code personal info. requested on this form is used in processing this form pursuant to COMAR 26.04.04. Failure to provide the info. may result in this form not being processed. You have the right to inspect, amend, or correct this form. The Maryland Department of the Environment is subject to the Maryland Public Information Act. This form may be made available on the Internet via MDE's website and is subject to inspection or copying, in whole or in part, by the pulic and other governmental agencies, if not protected by federal or state law.

MDE/WMA/PER.071

COUNTY

C 1 65746

SEQUENCE NO. (MDE USE ONLY)

1 2 3 6
(THIS NUMBER IS TO BE PUNCHED IN COLS. 3-6 ON ALL CARDS)

STATE OF MARYLAND
WELL COMPLETION REPORT

FILL IN THIS FORM COMPLETELY
PLEASE TYPE #3

THIS REPORT MUST BE SUBMITTED WITHIN 45 DAYS AFTER WELL IS COMPLETED.

COUNTY NUMBER 13

ST/CO USE ONLY
DATE Received MM DD YY 01 26 22 (8–13)

DATE WELL COMPLETED MM 12 DD 22 YY 2021 (15–20)

Approved 1/28/22 (S)

Depth of Well (22–26) 320' (TO NEAREST FOOT)

PERMIT NO. FROM "PERMIT TO DRILL WELL" HO - 20 - 0138 (28 29 30 31 32 33 34 35 36 37)

OWNER Dorko (last name) Stephen (first name)

WELL SITE ADDRESS 6731 Cortina Drive TOWN Highland

SUBDIVISION Lot 15 1.002A 6731 Cortina Dr. Deer track SECTION ______ LOT 15

WELL LOG

Not required for driven wells

STATE THE KIND OF FORMATIONS PENETRATED, THEIR COLOR, DEPTH, THICKNESS AND IF WATER BEARING

DESCRIPTION (Use additional sheets if needed)	FEET FROM	FEET TO	check if water bearing
Silt, mica, brown dry, trac Fine sand	0'	45'	
Weathered Rock gray	45'	60'	✓
Bed Rock gray. Wissahickon formation Lower Pelitic Schist.	60'	320'	✓
Installed 1.25 X 320' HDPE U-Bend loop.			

NUMBER OF UNSUCCESSFUL WELLS: 0

WELL HYDROFRACTURED yes Y [✓ no N]

CIRCLE APPROPRIATE LETTER
- A A WELL WAS ABANDONED AND SEALED WHEN THIS WELL WAS COMPLETED
- E ELECTRIC LOG OBTAINED
- P TEST WELL CONVERTED TO PRODUCTION WELL

I HEREBY CERTIFY THAT THIS WELL HAS BEEN CONSTRUCTED IN ACCORDANCE WITH COMAR 26.04.04 "WELL CONSTRUCTION" AND IN CONFORMANCE WITH ALL CONDITIONS STATED IN THE ABOVE CAPTIONED PERMIT, AND THAT THE INFORMATION PRESENTED HEREIN IS ACCURATE AND COMPLETE TO THE BEST OF MY KNOWLEDGE.

DRILLERS LIC. NO. M W D 5 8 7

DRILLERS SIGNATURE
(MUST MATCH SIGNATURE ON APPLICATION)

LIC. NO. A W D 0 6 3

SITE SUPERVISOR (sign. of driller or journeyman responsible for sitework if different from permittee)

GROUTING RECORD

WELL HAS BEEN GROUTED (Circle Appropriate Box) [✓ yes Y] no N (44)

TYPE OF GROUTING MATERIAL (Circle one)
CEMENT C M (45 46) [✓ BENTONITE CLAY B C] (45 46)

NO. OF BAGS 10 NO. OF POUNDS 500

GALLONS OF WATER 190

DEPTH OF GROUT SEAL (to nearest foot)
from 0 ft. (48 TOP 52) to 320' ft. (54 BOTTOM 58)
(enter 0 if from surface)

CASING RECORD

casing types insert appropriate code below

S T STEEL; C O CONCRETE; [✓ P L PLASTIC]; O T OTHER

MAIN CASING TYPE	Nominal diameter top (main) casing (nearest inch)!	Total depth of main casing (nearest foot)
PL (60 61)	6" (63 64)	60' (66 70)

OTHER CASING (if used)

EACH CASING	diameter inch	depth (feet) from	to

SCREEN RECORD

screen type or open hole insert appropriate code below

S T STEEL; B R BRASS BRONZE; [✓ H O OPEN HOLE]; P L PLASTIC; O T OTHER

C 2 (1 2)

DEPTH (nearest ft.)

EACH SCREEN	type	from	to
1	HO (8 9)	60' (11 15)	320' (17 21)
2	(23 24)	(26 30)	(32 36)
3	(38 39)	(41 45)	(47 51)

SLOT SIZE 1 ______ 2 ______ 3 ______

DIAMETER OF SCREEN ______ (56 60) (NEAREST INCH)

GRAVEL PACK from ______ to ______

IF WELL DRILLED WAS FLOWING WELL INSERT F IN BOX 68 ______ (68)

MDE USE ONLY
(NOT TO BE FILLED IN BY DRILLER)
T (E.R.O.S.) W Q
70 ___ TELESCOPE CASING
72 ___ LOG INDICATOR
74 75 76 OTHER DATA

C 3 (1 2)

PUMPING TEST

HOURS PUMPED (nearest hour) N/A (8 9)

PUMPING RATE (gal. per minute) N/A (11 15)

METHOD USED TO MEASURE PUMPING RATE N/A

WATER LEVEL (distance from land surface)

BEFORE PUMPING N/A ft. (17 20)

WHEN PUMPING N/A ft. (22 25)

TYPE OF PUMP USED (for test)
- A air (27)
- P piston (27)
- T turbine (27)
- C centrifugal (27)
- R rotary (27)
- O other (describe below) (27)
- J jet (27)
- S submersible (27)

PUMP INSTALLED

DRILLER INSTALLED PUMP (CIRCLE) (YES or NO) YES [✓ NO]

IF DRILLER INSTALLS PUMP, THIS SECTION MUST BE COMPLETED FOR ALL WELLS.

TYPE OF PUMP INSTALLED PLACE (A,C,J,P,R,S,T,O) IN BOX 29. N/A (29)

CAPACITY: GALLONS PER MINUTE (to nearest gallon) N/A (31 35)

PUMP HORSE POWER N/A (37 41)

PUMP COLUMN LENGTH (nearest ft.) N/A (43 47)

CASING HEIGHT (circle appropriate box and enter casing height)
+ above (49) [✓ − below] (49) LAND SURFACE -3 (50 51) (nearest foot)

LATITUDE 39.186074
LONGITUDE 76.987442
(DEFAULT COORD. WGS 84)

Pursuant to §10-624 of the State Govt. Article of the Maryand Code personal info. requested on this form is used in processing this form pursuant to COMAR 26.04.04. Failure to provide the info. may result in this form not being processed. You have the right to inspect, amend, or correct this form. The Maryland Department of the Environment is subject to the Maryland Public Information Act. This form may be made available on the Internet via MDE's website and is subject to inspection or copying, in whole or in part, by the pulic and other governmental agencies, if not protected by federal or state law.

MDE/WMA/PER.071

COUNTY

C 1 65745

1 2 3 6

SEQUENCE NO. (MDE USE ONLY)

(THIS NUMBER IS TO BE PUNCHED IN COLS. 3-6 ON ALL CARDS)

STATE OF MARYLAND
WELL COMPLETION REPORT
FILL IN THIS FORM COMPLETELY
PLEASE TYPE

#2

THIS REPORT MUST BE SUBMITTED WITHIN 45 DAYS AFTER WELL IS COMPLETED.

COUNTY NUMBER 13

ST/CO USE ONLY
DATE Received MM DD YY 01 26 22 (8-13)

DATE WELL COMPLETED MM 12 DD 22 YY 2021 (15-20)

Approved 1/28/22 ST

Depth of Well 22 320' 26 (TO NEAREST FOOT)

PERMIT NO. FROM "PERMIT TO DRILL WELL" HO - 20 - 0138 (28-37)

OWNER Dorko (last name) Stephen (first name)

WELL SITE ADDRESS 6731 Cortina Drive TOWN Highland.

SUBDIVISION Lot 15 1.002A. 6731 Cortina Dr. Deer track SECTION ______ LOT 15

WELL LOG
Not required for driven wells

STATE THE KIND OF FORMATIONS PENETRATED, THEIR COLOR, DEPTH, THICKNESS AND IF WATER BEARING

DESCRIPTION (Use additional sheets if needed)	FEET FROM	FEET TO	check if water bearing
Silt brown mica, dry trac fine Sand	0'	45'	
weathered Rock gray	45'	60'	✓
Bed rock gray wissahickon formation Lower pelitic Schist.	60'	320'	✓
Installed 1.25" x 320' HDPE U-Bend loop			

NUMBER OF UNSUCCESSFUL WELLS: 0

WELL HYDROFRACTURED yes Y [✓ no N]

CIRCLE APPROPRIATE LETTER
- **A** A WELL WAS ABANDONED AND SEALED WHEN THIS WELL WAS COMPLETED
- **E** ELECTRIC LOG OBTAINED
- **P** TEST WELL CONVERTED TO PRODUCTION WELL

I HEREBY CERTIFY THAT THIS WELL HAS BEEN CONSTRUCTED IN ACCORDANCE WITH COMAR 26.04.04 "WELL CONSTRUCTION" AND IN CONFORMANCE WITH ALL CONDITIONS STATED IN THE ABOVE CAPTIONED PERMIT, AND THAT THE INFORMATION PRESENTED HEREIN IS ACCURATE AND COMPLETE TO THE BEST OF MY KNOWLEDGE.

DRILLERS LIC. NO. MWD 587

DRILLERS SIGNATURE (MUST MATCH SIGNATURE ON APPLICATION)

LIC. NO. AWD 063

SITE SUPERVISOR (sign. of driller or journeyman responsible for sitework if different from permittee)

GROUTING RECORD

WELL HAS BEEN GROUTED (Circle Appropriate Box) [✓ yes Y] no N (44)

TYPE OF GROUTING MATERIAL (Circle one)

CEMENT CM (45 46) [✓ BENTONITE CLAY BC] (45 46)

NO. OF BAGS 10 NO. OF POUNDS 500

GALLONS OF WATER 190

DEPTH OF GROUT SEAL (to nearest foot)

from 0' (48 TOP 52) ft. to 320' (54 BOTTOM 58) ft.

(enter 0 if from surface)

CASING RECORD

casing types insert appropriate code below

ST STEEL | CO CONCRETE | [✓ PL PLASTIC] | OT OTHER

MAIN CASING TYPE	Nominal diameter top (main) casing (nearest inch)!	Total depth of main casing (nearest foot)
PL (60 61)	6" (63 64)	60' (66-70)

EACH CASING

OTHER CASING (if used)

	diameter inch	depth (feet) from	to

SCREEN RECORD

screen type or open hole insert appropriate code below

ST STEEL | BR BRASS BRONZE | [✓ HO OPEN HOLE] | PL PLASTIC | OT OTHER

C 2 (1 2)

DEPTH (nearest ft.)

EACH SCREEN

		from	to
1	HO (8 9)	60' (11 15)	320' (17 21)
2	(23 24)	(26 30)	(32 36)
3	(38 39)	(41 45)	(47 51)

SLOT SIZE 1 ______ 2 ______ 3 ______

DIAMETER OF SCREEN ______ (56 60) (NEAREST INCH)

GRAVEL PACK from ______ to ______

IF WELL DRILLED WAS FLOWING WELL INSERT F IN BOX 68

MDE USE ONLY
(NOT TO BE FILLED IN BY DRILLER)

T (70) TELESCOPE CASING | (E.R.O.S.) (72) LOG INDICATOR | W Q (74 75 76) OTHER DATA

C 3 (1 2)

PUMPING TEST

HOURS PUMPED (nearest hour) N/A (8 9)

PUMPING RATE (gal. per min.) N/A (11-15)

METHOD USED TO MEASURE PUMPING RATE N/A

WATER LEVEL (distance from land surface)

BEFORE PUMPING N/A ft. (17-20)

WHEN PUMPING N/A ft. (22-25)

TYPE OF PUMP USED (for test)
- A air (27)
- P piston (27)
- T turbine (27)
- C centrifugal (27)
- R rotary (27)
- O other (describe below) (27)
- J jet (27)
- S submersible (27)

PUMP INSTALLED

DRILLER INSTALLED PUMP (CIRCLE) (YES or NO) YES [✓ NO]

IF DRILLER INSTALLS PUMP, THIS SECTION MUST BE COMPLETED FOR ALL WELLS.

TYPE OF PUMP INSTALLED PLACE (A,C,J,P,R,S,T,O) IN BOX 29. N/A

CAPACITY: GALLONS PER MINUTE (to nearest gallon) N/A (31-35)

PUMP HORSE POWER N/A (37-41)

PUMP COLUMN LENGTH (nearest ft.) N/A (43-47)

CASING HEIGHT (circle appropriate box and enter casing height)

+ above (49) [✓ − below (49)] LAND SURFACE -3 (50 51) (nearest foot)

LATITUDE 39.186048

LONGITUDE 76.987427

(DEFAULT COORD. WGS 84)

Pursuant to §10-624 of the State Govt. Article of the Maryand Code personal info. requested on this form is used in processing this form pursuant to COMAR 26.04.04. Failure to provide the info. may result in this form not being processed. You have the right to inspect, amend, or correct this form. The Maryland Department of the Environment is subject to the Maryland Public Information Act. This form may be made available on the Internet via MDE's website and is subject to inspection or copying, in whole or in part, by the pulic and other governmental agencies, if not protected by federal or state law.

MDE/WMA/PER.071

COUNTY

EMERGENCY/TEMP NO. IF ANY

B 1 79907
1 2 3 6

SEQUENCE NO. (MDE USE ONLY)

STATE OF MARYLAND
APPLICATION FOR PERMIT TO DRILL WELL

570213
please type

STATE PERMIT NUMBER
HO - 20 - 0138
70 fill in this form completely 79

Date Received (APA) 10 20 21
8 MM DD YY 13

OWNER INFORMATION

Last Name: Dorko — Owner — First Name: Stephen (15–34)
Street or RFD: 6731 Cortina Drive (36–55)
Town: Highland (57) State: Md. (70) Zip: 20777 (72–76)

DRILLER INFORMATION

Driller's Name: Stephen DeLosh (76) License No. MW D 587 (81)
Firm Name: Connelly & Associates, Inc.
Address: 1513 Tilco Drive Frederick, Md. 21704
Signature: Stephen DeLosh Date: 10-20-2021

B 2 WELL INFORMATION
1 2
APPROX. PUMPING RATE (GAL. PER MIN.) N/A 8 12
AVERAGE DAILY QUANTITY NEEDED (GAL. PER DAY) N/A 14 20

B 3 LOCATION OF WELL

COUNTY: Howard (8–21)
SUBDIVISION: Lot 15 1.002 A. 6731 Cortina Dr. Deer Tracks (23–42)
SECTION ___ 44 46 LOT 15 48 50
NEAREST TOWN: Highland (52–71)

B 4

SOURCES OF DRILLING WATER
1. Private
2.
3. 12/21/21

all bores grouted
w/ wye ben
Groundwater

6731 Cortina Drive
11 STREET ADDRESS 30

ON WHICH SIDE OF ROAD (CIRCLE APPROPRIATE BOX)
NORTH N / W 32 E / [✓ S] SOUTH

34 325 37
DISTANCE FROM ROAD FT
ENTER [✓ FT] OR MI 38 39

TAX MAP: 0034 BLK: 9999 PARCEL 0129

USE FOR WATER (CIRCLE APPROPRIATE BOX)

22
- ☐ D DOMESTIC POTABLE SUPPLY & RESIDENTIAL IRRIGATION
- ☐ F FARMING (LIVESTOCK WATERING & AGRICULTURAL IRRIGATION)
- ☐ I INDUSTRIAL, COMMERCIAL, DEWATERING
- ☐ P PUBLIC WATER SUPPLY WELL
- ☐ T TEST, OBSERVATION, MONITORING
- ☐ O OPEN LOOP GEOTHERMAL
- [✓ C] CLOSED LOOP GEOTHERMAL

NOT TO BE FILLED IN BY DRILLER
HEALTH DEPARTMENT APPROVAL

COUNTY NAME: Howard COUNTY NO. 13
STATE SIGNATURE ________ INSERT S → ___ 41
DATE ISSUED: 10/22/21 (43 MM DD YY 48) CO SIGNATURE: Susan Thomas EXP. DATE: 10/22/21

DON 12/20/21 (ST) DDG 12/21/21 (ST)

APPROXIMATE DEPTH OF WELL 320 FEET (24 28)

APPROXIMATE DIAMETER OF WELL 6 NEAREST INCH

METHOD OF DRILLING (circle one)

BORED (or Augered) JETTED Jetted & DRIVEN
30 AIR-ROTary [✓ AIR-PERcussion] ROTARY (Hydraulic Rotary)
37 CABLE REVerse-ROTary DRive-POINT
other ________

REPLACEMENT OR DEEPENED WELLS
(CIRCLE APPROPRIATE BOX)

39
- [✓ N] THIS WELL WILL NOT REPLACE AN EXISTING WELL
- ☐ Y THIS WELL WILL REPLACE A WELL THAT WILL BE ABANDONED AND SEALED
- ☐ S THIS WELL WILL REPLACE A WELL THAT WILL BE USED AS A STANDBY-CONTACT LOCAL APPROVING AUTHORITY FOR POLICY ON STANDBY WELLS
- ☐ D THIS WELL WILL DEEPEN AN EXISTING WELL

PERMIT NUMBER OF WELL TO BE REPLACED OR DEEPENED (IF AVAILABLE) 41 __ __ - __ __ - __ __ __ __ 52

Not to be filled in by driller (MDE OR COUNTY USE ONLY)

APPROP. PERMIT NUMBER _ _ _ _ _ _ G _ _ _

PERMIT No. HO-20-0138
70 71 72 73 74 75 76 77 78 79

PROPOSED LOCATION OF WELL ON LOT
SHOW PERMANENT STRUCTURES SUCH AS BUILDINGS, SEPTIC SYSTEM, ROADS AND/OR LANDMARKS AND INDICATE NOT LESS THAN TWO DISTANCE MEASUREMENTS TO WELL

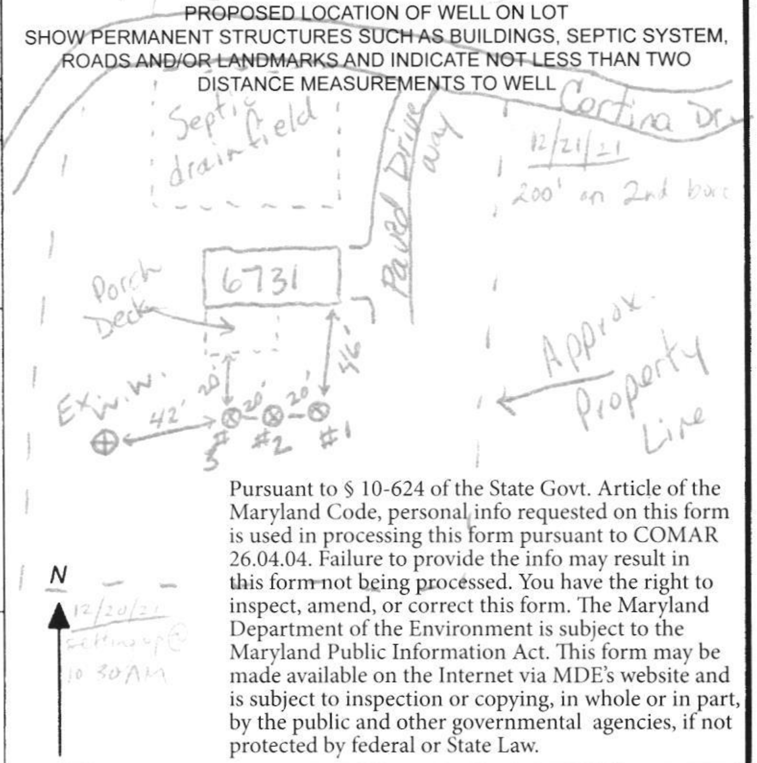

12/21/21
200' on 2nd bore

12/20/21
setting up @
10 30 AM

Pursuant to § 10-624 of the State Govt. Article of the Maryland Code, personal info requested on this form is used in processing this form pursuant to COMAR 26.04.04. Failure to provide the info may result in this form not being processed. You have the right to inspect, amend, or correct this form. The Maryland Department of the Environment is subject to the Maryland Public Information Act. This form may be made available on the Internet via MDE's website and is subject to inspection or copying, in whole or in part, by the public and other governmental agencies, if not protected by federal or State Law.

SPECIAL CONDITIONS
NOTE APPROVING AUTHORITIES SHOULD USE SEPARATE SHEET IF NEEDED

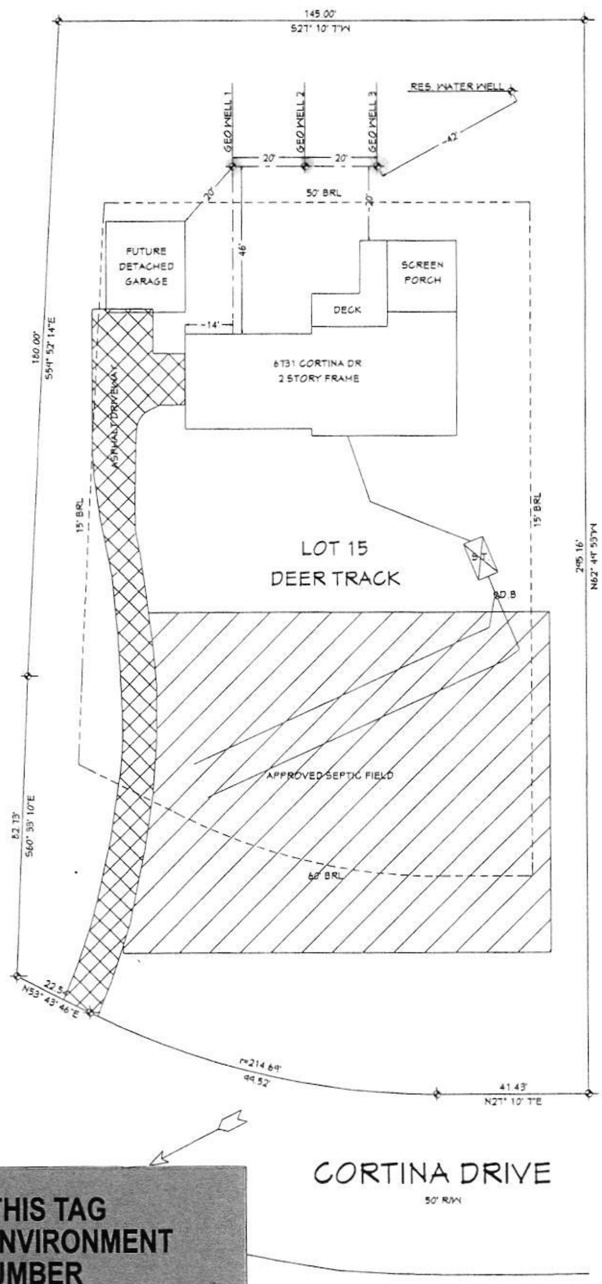

DO NOT REMOVE THIS TAG
DEPARTMENT OF THE ENVIRONMENT
WELL PERMIT NUMBER

HO-20- 0138

INFORMATION - GIVE NUMBER AND WRITE
1800 WASHINGTON BLVD
BALTIMORE MARYLAND 21230

Approved 10/22/21 (ST)
Staked by driller

3 @ 320'

6731 CORTINA DR.

GEOTHERMAL WELL LOCATION

SCALE : 1" = 50'

DATE: 8/19/2021

Howard County
Health Department

Bureau of Environmental Health
8930 Stanford Boulevard, Columbia, MD 21045
Main: 410-313-2640 | Fax: 410-313-2648
TDD 410-313-2323 | Toll Free 1-866-313-6300
www.hchealth.org
Facebook: www.facebook.com/hocohealth
Twitter: HowardCoHealthDep

Dr. Maura J. Rossman, M.D., Health Officer

TO ALL INTERESTED PARTIES

When submitting a well permit application for a proposed well for new construction, please indicate one of the following:

Well Site Location:

1.002 A. 6731 Cortina Dr. Deer Track	15	Cortina Drive
Subdivision/Property Name	Lot #	Road Name

☒ The well site has been staked by Connelly & Associates Inc.
(professional land surveyor or company employing professional land surveyors)
on ______________ (date) and does not require a site inspection.

☐ The well driller, builder or property owner will call the Health Department to schedule a time to meet in the field to verify the proposed well site location.

This sheet, along with two copies of an acceptable well site plan, must be attached to the green well permit application.

Revised 4/22/14

ConnellyGeothermal
Partnering with Mother Earth

Dorko Residence: 6731 Cortina Drive Highland, Md. Geothermal Closed Loop

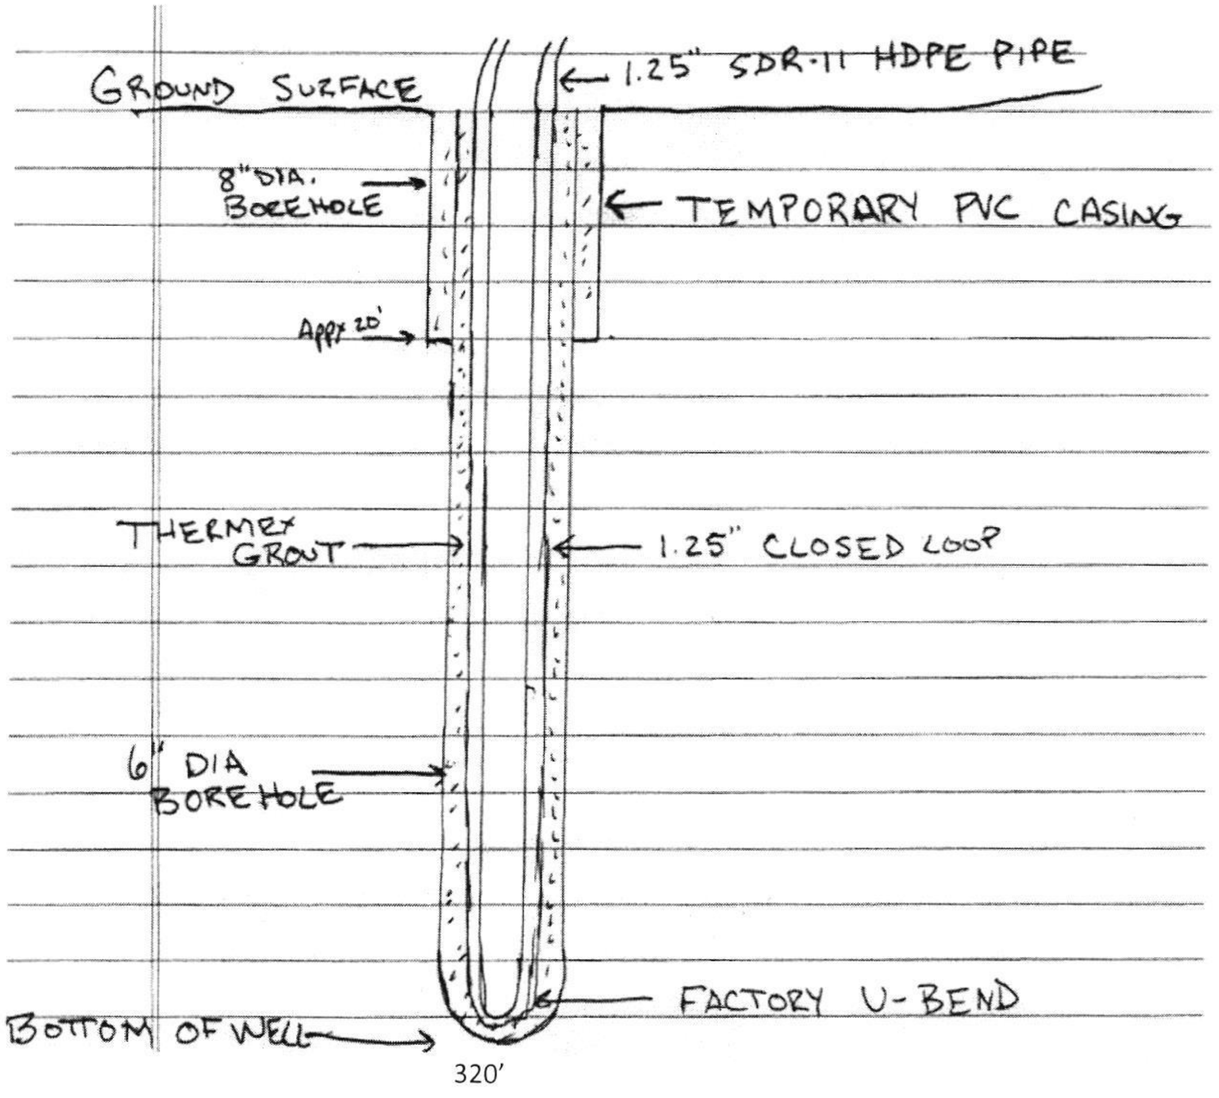

Grout information for this property is as follows:

Well Grout DF grout mixture of 50 lb. grout to 19 gallons water, placed in the well using the tremie method, from bottom to top.