HOWARD COUNTY
HEALTH DEPARTMENT

Bureau of Environmental Health
8930 Stanford Blvd | Columbia, MD 21045
410.313.2640 - Voice/Relay
410.313.2648 - Fax
1.866.313.6300 - Toll Free

Maura J. Rossman, M.D., Health Officer

MEMORANDUM

Sent via email to jespo47@gmail.com

TO: Joseph Esposito

FROM: Kevin M. Wolf, LEHS, REHS/RS, Supervisor
Groundwater Mgmt. Sec.
Well & Septic Program

DATE: September 23, 2021

RE: 11493, 11489 Frederick Road
Ellicott City, MD 21042
M. 16 P. 198/144 17, 293SF/2.06AC
(Demolition of existing houses, return to grass land)

This is to advise that the Howard County Health Department recommends issuance of the demolition permit for the above referenced property.

The existing drilled wells (tags unknown) that were utilized for the above referenced properties were located and sealed by Andrew Houseman (MSD224) on 9/10/2021. The well abandonment reports were received by our office and reviewed for compliance.

The existing septic systems that served the houses consisted of a concrete septic tank and trenches. Both were pumped out and collapsed by Fogle's on 9/9/2021 respectively. Proper documenation was submitted to our office for record of confirmation.

Future plans to rebuild on the subject property will require a percolation certification plan and the development of a private well system.

IF ANY WELL OR SEPTIC COMPONENTS ARE FOUND DURING SITE WORK, YOU MUST NOTIFY THIS OFFICE IMMEDIATELY!!

KMW
Cc: File

Howard County Health Department

Bureau of Environmental Health
8930 Stanford Boulevard, Columbia, MD 21045
Main: 410-313-2640 | Fax: 410-313-2648
TDD 410-313-2323 | Toll Free 1-866-313-6300
www.hchealth.org
Facebook: www.facebook.com/hocohealth
Twitter: HowardCoHealthDep

Maura J. Rossman, M.D., Health Officer

DEMOLITION REQUEST FORM

Information of Property to be Demolished:

RAVI + UMA ANADA KRISHNAN
Current Owner's Name

11499 FREDERICK RD. ELLICOTT CITY, 21042
Property Address

Subdivision (if applicable)

6
Lot #

All Prior Owners' Names (if requested or known)

Tax Map

03-251698
Parcel #

Tax ID #

UNSAFE ABANDONED STRUCTURE
Purpose/Reason for Demolition

UNKNOWN
Future plans of property after demo (i.e. subdivision, parking lot, re-build new house, etc…)

If a subdivision, SDP# _____ Has the structure(s) been deemed unsafe by DILP ___ YES ___ NO

UTILITY RECORDS:

Property currently connected to public water ___ YES _✓_ NO

Property currently connected to public sewer ___ YES ✓ NO

Does the property currently have any wells and/or septic systems ✓ YES ___ NO
→Explain: HAS WELL + SEPTIC

*Note: Any wells and/or septic systems that are to remain may require an approved percolation certification plan under *Howard County Code Sec. 3.805*
*Note: Any septic systems that are to be abandoned must be done by a septic contractor with documentation of the process.
*Note: All abandoned wells are to be sealed by a well driller licensed by the Maryland State Board of Well Drillers. *COMAR 26.04.04.11 Abandonment Standards D (3)*

COMMENTS:

JOSEPH ESPOSITO
Applicant's Name (please print)

410-375-9067
Applicant's Phone #

JESPO4@GMAIL.COM
Applicant's Email

Applicant's Fax #

Applicant's Signature

09/20/21
Date

Howard County Health Department

Bureau of Environmental Health
8930 Stanford Boulevard, Columbia, MD 21045
Main: 410-313-2640 | Fax: 410-313-2648
TDD 410-313-2323 | Toll Free 1-866-313-6300
www.hchealth.org
Facebook: www.facebook.com/hocohealth
Twitter: HowardCoHealthDep

Maura J. Rossman, M.D., Health Officer

DEMOLITION REQUEST FORM

Information of Property to be Demolished:

RAVI + UMA ANANDA KRISHNAN
Current Owner's Name

11489 FREDERICK RD. ELLICOTT CITY, 21042
Property Address

Subdivision (if applicable)

10
Lot #

All Prior Owners' Names (if requested or known)

Tax Map | 03-284698 Parcel # | Tax ID #

UNSAFE ABANDONED STRUCTURE
Purpose/Reason for Demolition

UNKNOWN
Future plans of property after demo (i.e. subdivision, parking lot, re-build new house, etc...)

If a subdivision, SDP# _____ Has the structure(s) been deemed unsafe by DILP ___ YES ___ NO

UTILITY RECORDS:

Property currently connected to public water ___ YES ✓ NO

Property currently connected to public sewer ___ YES ✓ NO

Does the property currently have any wells and/or septic systems ✓ YES ___ NO
→Explain: HAS WELL + SEPTIC

*Note: Any wells and/or septic systems that are to remain may require an approved percolation certification plan under *Howard County Code Sec. 3.805*
*Note: Any septic systems that are to be abandoned must be done by a septic contractor with documentation of the process.
*Note: All abandoned wells are to be sealed by a well driller licensed by the Maryland State Board of Well Drillers *COMAR Sec. 26.04.04.11 Abandonment Standards D (3)*

COMMENTS:

JOSEPH ESPOSITO
Applicant's Name (please print)

410-375-9047
Applicant's Phone #

JESPO4@GMAIL.COM
Applicant's Email

Applicant's Fax #

Applicant's Signature

09/20/21
Date

MARYLAND DEPARTMENT OF THE ENVIRONMENT, WATER MANAGEMENT ADMINISTRATION
1800 Washington Blvd., Baltimore, Maryland 21230 (410) 537-3784

****

WATER WELL ABANDONMENT-SEALING REPORT FORM

****

SUBMIT COPIES OF COMPLETED FORM TO:
* COUNTY ENVIRONMENTAL AGENCY (contact MDE, WMA if address needed)
* WELL OWNER
* MDE, WATER MANAGEMENT ADMINISTRATION, WELL PROGRAM

DATE WELL ABANDONED: 9-10-21 (month/day/year)

* PERMIT NUMBER OF ABANDONED WELL (if any) No tag

* PERMIT NUMBER OF REPLACEMENT WELL: — —

* PERSON ABANDONING WELL: Andrew Houseman WELL DRILLER'S LICENSE NUMBER: 224
CIRCLE: MWD / MSD / MGD

* OWNER'S NAME: Ravi Anandakrishnan

* WELL LOCATION:
COUNTY: Howard
NEAREST TOWN: Ellicott City
TAX MAP 0016 BLOCK 0015 PARCEL 0198
SUBDIVISION:
SECTION: 8 LOT:
STREET ADDRESS: 11488 Frederick Rd

LATITUDE 39.291395

LONGITUDE 76.210674

SITE LOCATION MAP

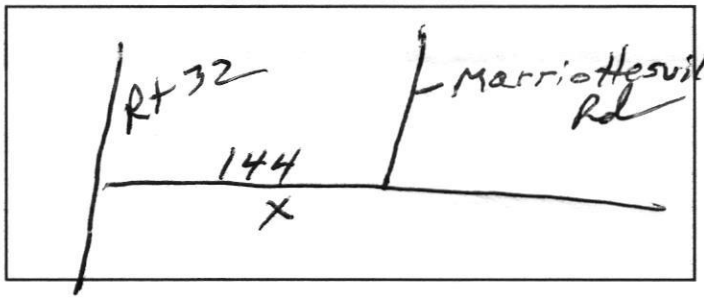

LOG OF SEALING MATERIAL

MATERIAL	FEET	
	FROM	TO
Bentonite	50	0
VOLUME OF MATERIAL USED		
Bentonite 750 lbs		

* TYPE OF WELL BEING ABANDONED:
✓ DRILLED _____ JETTED
_____ BORED _____ HAND DUG
_____ OTHER (specify)_____

* USE CODE:
✓ DOMESTIC _____ MUNICIPAL/PUBLIC
_____ IRRIGATION _____ INDUSTRIAL
_____ TEST/OBSERVATION _____ GEOTHERMAL

* TYPE OF CASING:
✓ STEEL _____ PLASTIC
_____ CONCRETE _____ OTHER (specify)
_____

SIZE OF CASING: 6 INCHES IN DIAMETER

DEPTH OF WELL: 50 FEET DEEP

WAS ANY CASING REMOVED? ____ YES ✓ NO
If yes, length removed, in feet: _____

WAS CASING RIPPED OR PERFORATED? ____ YES ✓ NO

Pursuant to § 10-624 of the State Govt. Article of the Maryland Code, personal info requested on this form is used in processing this form pursuant to COMAR 26.04.04. Failure to provide the info may result in this form not being processed. You have the right to inspect, amend, or correct this form. The Maryland Department of the Environment is subject to the Maryland Public Information Act. This form may be made available on the Internet via MDE's website and is subject to inspection or copying, in whole or in part, by the public and other governmental agencies, if not protected by federal or State Law.

Andrew Houseman 224 MWD / MSD / MGS 9-10-21

SIGNATURE-MASTER WELL DRILLER OR SUPERVISING SANITARIAN LICENSE# CIRCLE ONE DATE

ORIGINAL

MARYLAND DEPARTMENT OF THE ENVIRONMENT, WATER MANAGEMENT ADMINISTRATION
1800 Washington Blvd., Baltimore, Maryland 21230 (410) 537-3784

WATER WELL ABANDONMENT-SEALING REPORT FORM

SUBMIT COPIES OF COMPLETED FORM TO:
* COUNTY ENVIRONMENTAL AGENCY (contact MDE, WMA if address needed)
* WELL OWNER
* MDE, WATER MANAGEMENT ADMINISTRATION, WELL PROGRAM

DATE WELL ABANDONED: 9-10-21 (month/day/year)

* PERMIT NUMBER OF ABANDONED WELL (if any): No tags
* PERMIT NUMBER OF REPLACEMENT WELL:
* PERSON ABANDONING WELL: Andrew Houseman WELL DRILLER'S LICENSE NUMBER: 224
CIRCLE: MWD / (MSD) / MGD
* OWNER'S NAME: Ravi Arandakrishnan

* WELL LOCATION:
COUNTY: Howard
NEAREST TOWN: Ellicott City
TAX MAP 0016 BLOCK 0021 PARCEL 6144
SUBDIVISION:
SECTION: 23 LOT:
STREET ADDRESS: 1148 Frederick Rd

LATITUDE 39.291475
LONGITUDE 76.910809

SITE LOCATION MAP

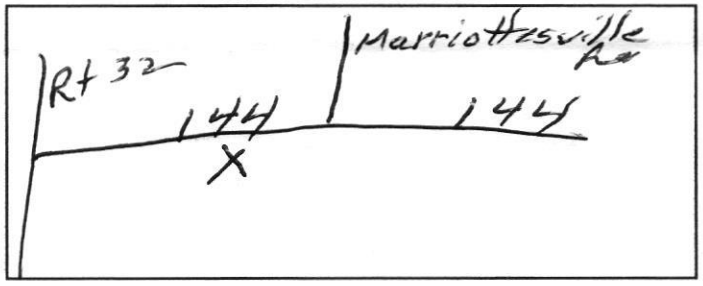

LOG OF SEALING MATERIAL

MATERIAL	FEET	
	FROM	TO
Bentonite	35	0

VOLUME OF MATERIAL USED

Bentonite 600 lbs

* TYPE OF WELL BEING ABANDONED:
✓ DRILLED ____ JETTED
____ BORED ____ HAND DUG
____ OTHER (specify)____

* USE CODE:
✓ DOMESTIC ____ MUNICIPAL/PUBLIC
____ IRRIGATION ____ INDUSTRIAL
____ TEST/OBSERVATION ____ GEOTHERMAL

* TYPE OF CASING:
✓ STEEL ____ PLASTIC
____ CONCRETE ____ OTHER (specify)

SIZE OF CASING: 6 INCHES IN DIAMETER

DEPTH OF WELL: 35 FEET DEEP

WAS ANY CASING REMOVED? ____ YES ✓ NO
If yes, length removed, in feet:____

WAS CASING RIPPED OR PERFORATED? ____ YES ✓ NO

Pursuant to § 10-624 of the State Govt. Article of the Maryland Code, personal info requested on this form is used in processing this form pursuant to COMAR 26.04.04. Failure to provide the info may result in this form not being processed. You have the right to inspect, amend, or correct this form. The Maryland Department of the Environment is subject to the Maryland Public Information Act. This form may be made available on the Internet via MDE's website and is subject to inspection or copying, in whole or in part, by the public and other governmental agencies, if not protected by federal or State Law.

Taylor R Houseman 224 MWD / (MSD) / MGS 9-10-21
SIGNATURE-MASTER WELL DRILLER OR SUPERVISING SANITARIAN LICENSE# CIRCLE ONE DATE

ORIGINAL

Fogle's Septic Clean Inc.

Fogle's Portable Toilets • Fogle's Well Drilling LLC • Fogle's Excavating, LLC

FOGLE'S
SEPTIC & PORTABLES
410-795-5670

September 13, 2021

Howard Co Dept of Environmental Health
8930 Stanford Blvd
Columbia, Md 21045

To Whom it may concern,

On September 9, 2021 Fogle's Septic Clean Inc, has pumped, crushed and filled in 2 old septic tanks located at 11489 & 11493 Frederick Rd for Eesposito Company Inc. See attached drawings.
If you have any questions please call me at the office 410-795-5670.

Sincerely,

Kurt Cassell

Kurt Cassell
Fogle's Septic Clean, Inc.

580 Obrecht Road • Sykesville, Maryland 21784
Phone (410) 795-5670 FAX (410) 795-3432

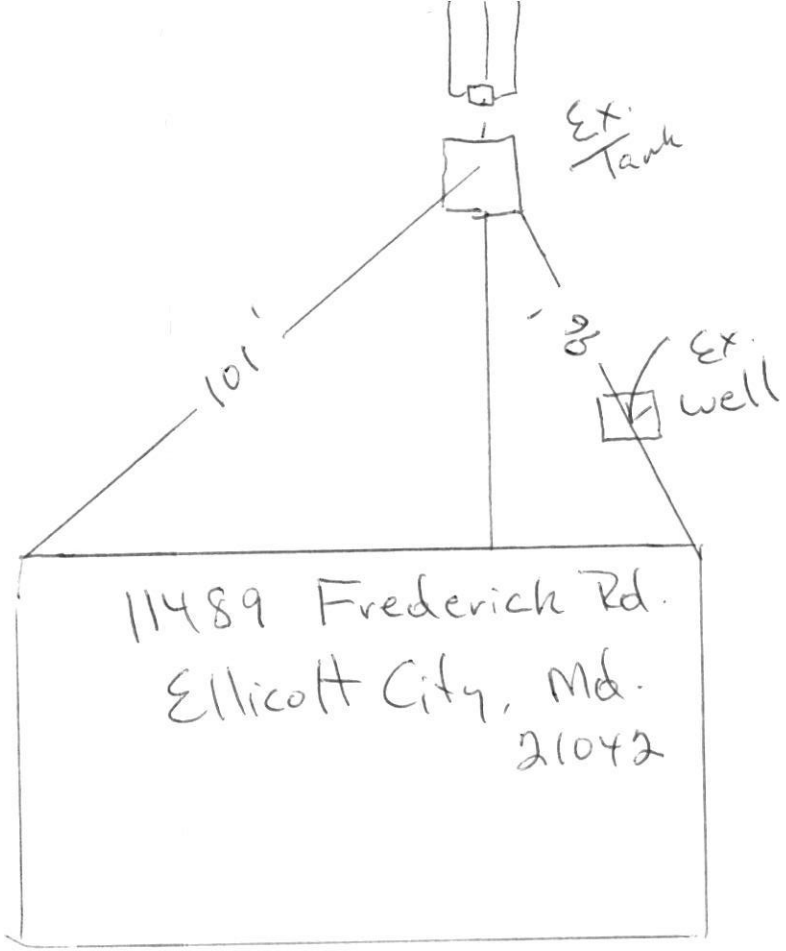

Frederick Rd

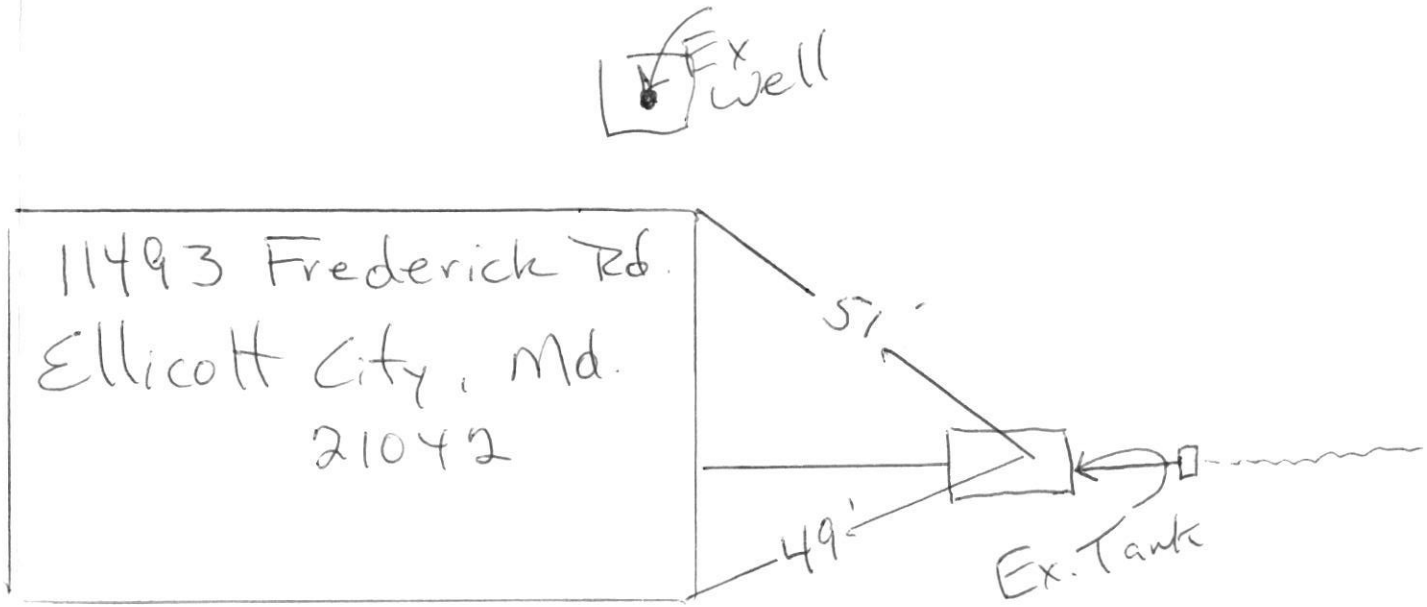

Frederick Rd