

Right Side

Rear

Front Side

Left Side

2x6 Interior walls

2x4 Interior walls

SHEET TITLE:

Third Floor Plan

NO.	DESCRIPTION	BY	DATE

PROJECT DESCRIPTION:  
**1872-CHB3-H-T**


**1872 Woodbine Road  
Woodbine, Md. 21797**

DRAWINGS PROVIDED BY:  
**Charles Hanford Designs**  
c/o Chuck Browning  
301 252-6865  
Chuckspalm@gmail.com

DATE:  
3-31-2021

SCALE:  
1/4" = 1'

SHEET:  
**A-4**

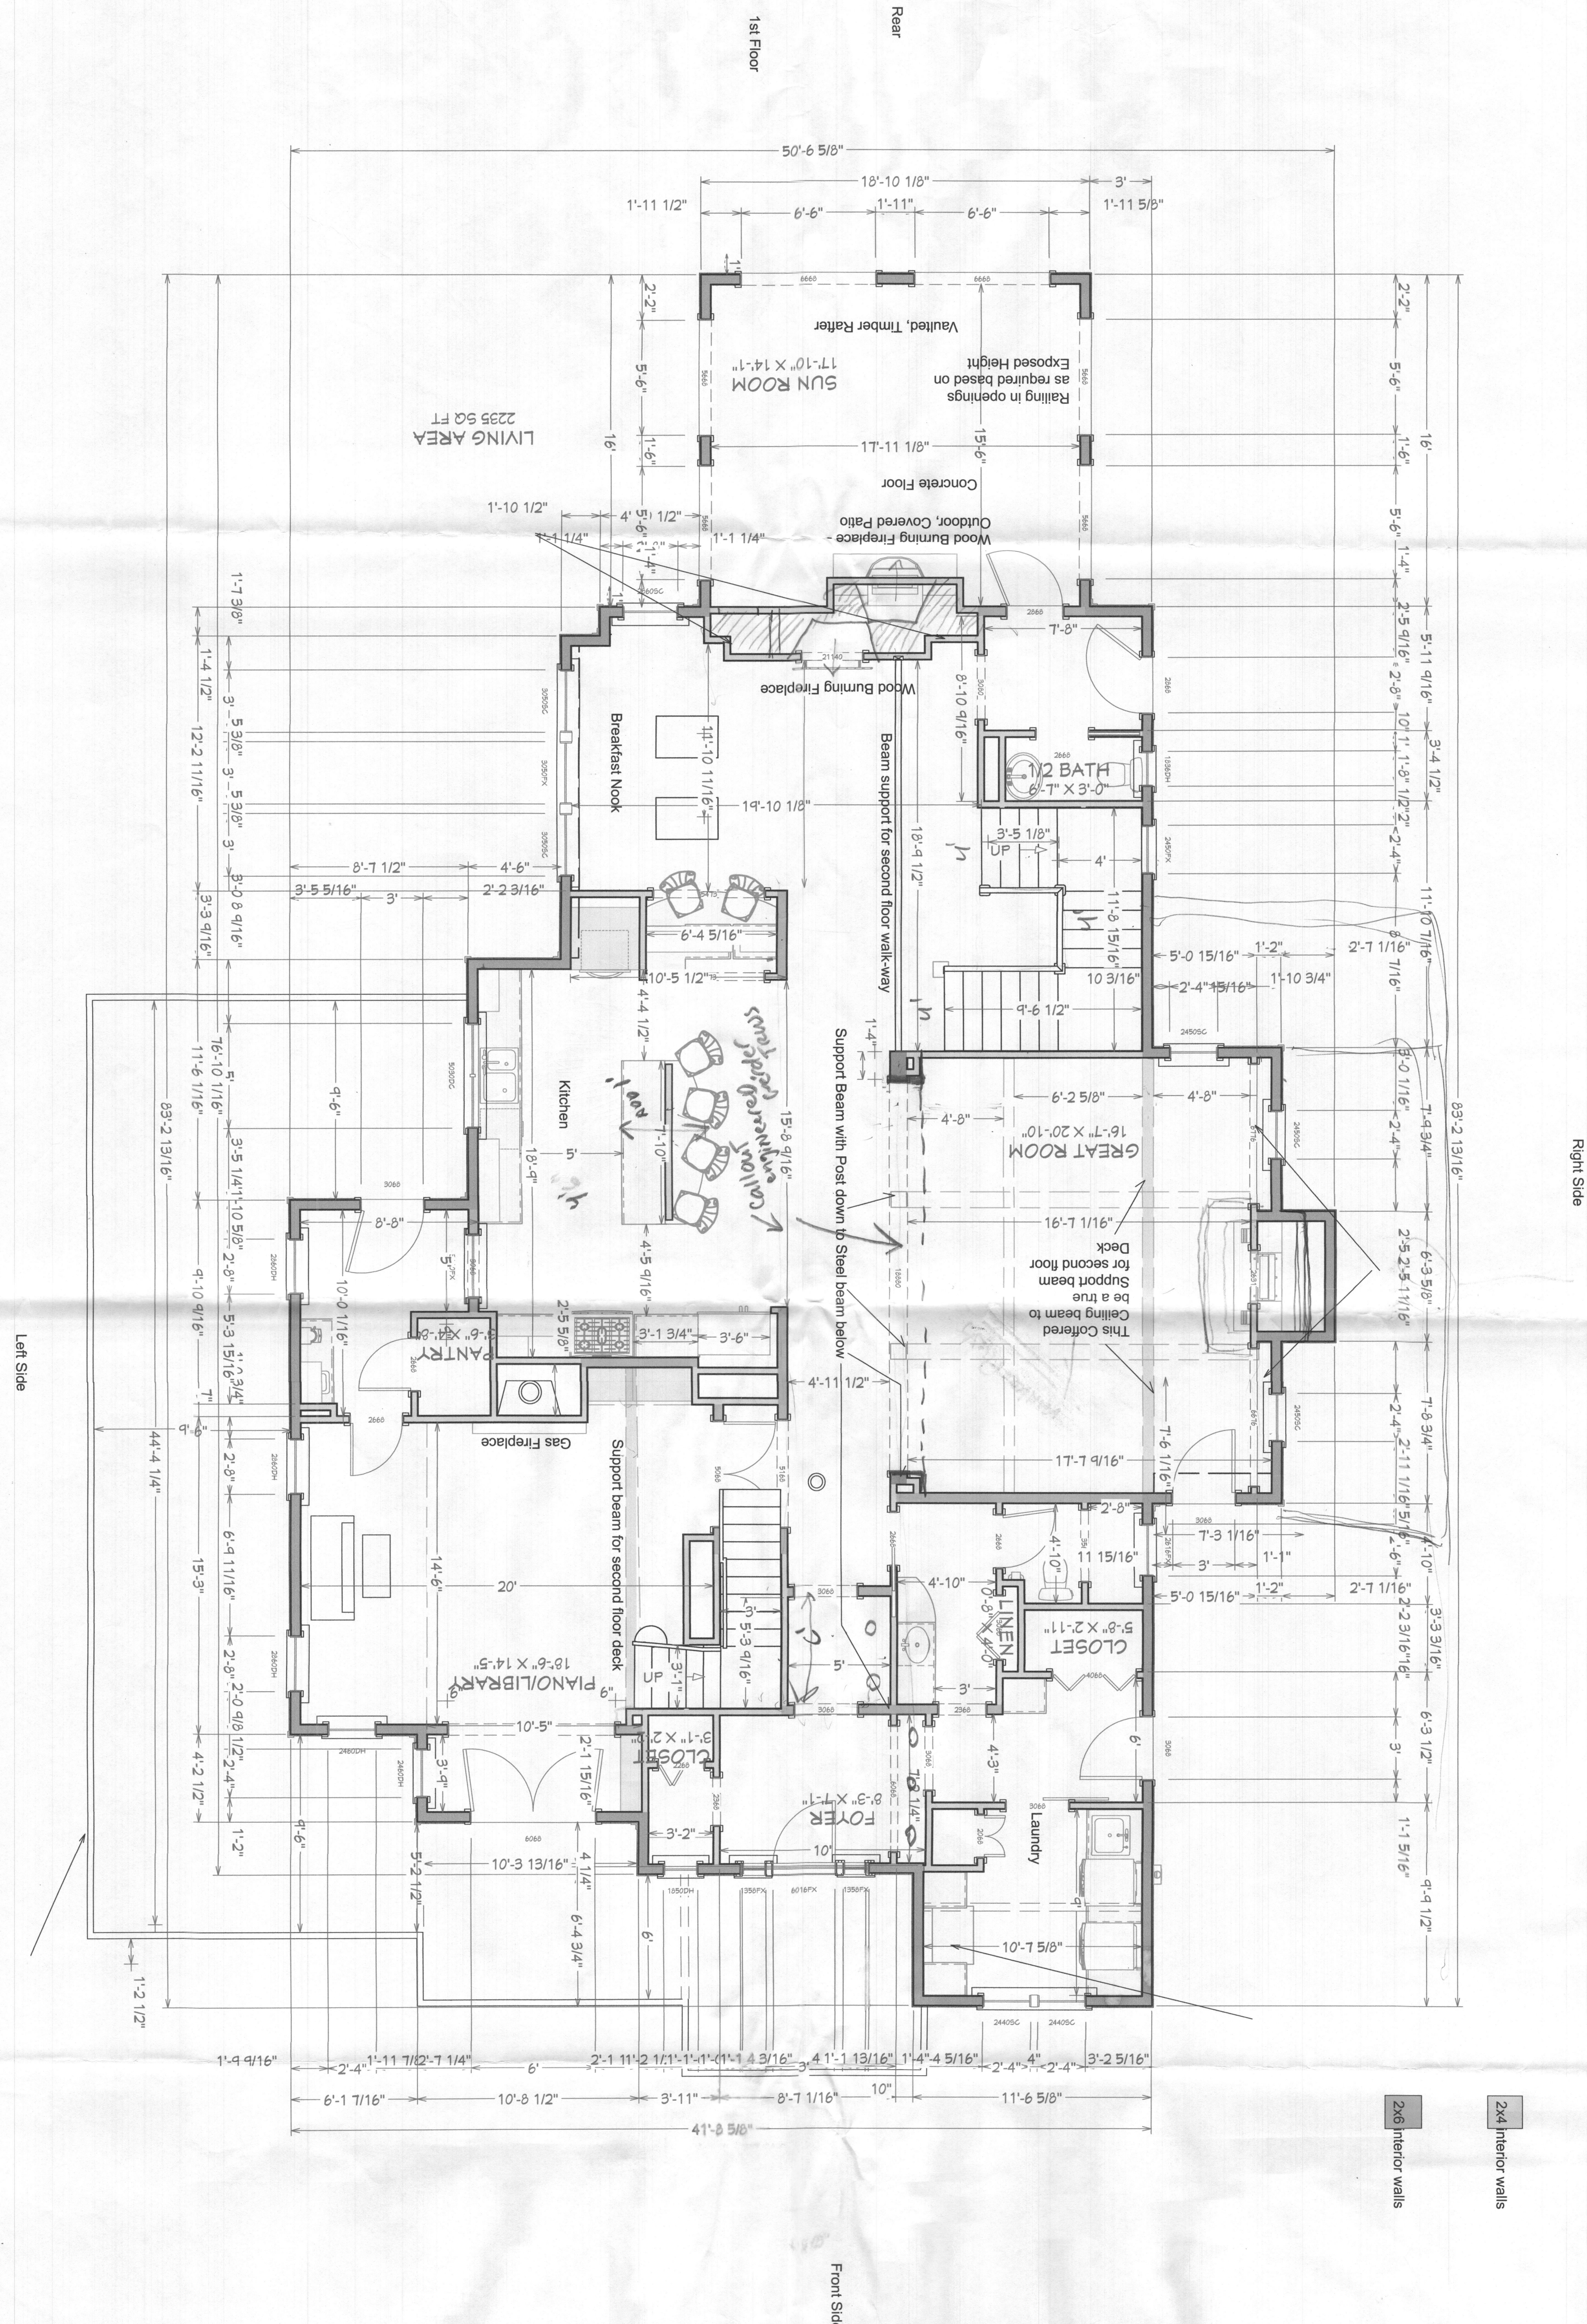

<b>CHARLES HANFORD DESIGNS</b> c/o Chuck Browning 301 252-6865 Chuckspalm@gmail.com	<b>PROJECT DESCRIPTION:</b> <b>1872-CHB3-H-T</b> <b>1872 Woodbine Road</b> <b>Woodbine, Md. 21797</b>	<b>SHEET TITLE:</b> <b>First Floor Plan</b>	<table border="1" style="width: 100%; border-collapse: collapse;"> <thead> <tr> <th style="width: 5%;">NO.</th> <th style="width: 65%;">DESCRIPTION</th> <th style="width: 10%;">BY</th> <th style="width: 20%;">DATE</th> </tr> </thead> <tbody> <tr><td> </td><td> </td><td> </td><td> </td></tr> <tr><td> </td><td> </td><td> </td><td> </td></tr> <tr><td> </td><td> </td><td> </td><td> </td></tr> <tr><td> </td><td> </td><td> </td><td> </td></tr> <tr><td> </td><td> </td><td> </td><td> </td></tr> <tr><td> </td><td> </td><td> </td><td> </td></tr> <tr><td> </td><td> </td><td> </td><td> </td></tr> <tr><td> </td><td> </td><td> </td><td> </td></tr> <tr><td> </td><td> </td><td> </td><td> </td></tr> <tr><td> </td><td> </td><td> </td><td> </td></tr> </tbody> </table>	NO.	DESCRIPTION	BY	DATE	
NO.	DESCRIPTION	BY	DATE	
<b>DATE:</b> 3-31-2021	<b>SCALE:</b> 1/4" = 1'	<b>SHEET:</b> <b>A-2</b>	