MARYLAND DEPARTMENT OF THE ENVIRONMENT, WATER MANAGEMENT ADMINISTRATION
1800 Washington Blvd., Baltimore, Maryland 21230 (410) 537-3784 OK MB 3/20/25

WATER WELL ABANDONMENT-SEALING REPORT FORM

SUBMIT COPIES OF COMPLETED FORM TO:

* COUNTY ENVIRONMENTAL AGENCY (contact MDE, WMA if address needed)
* WELL OWNER
* MDE, WATER MANAGEMENT ADMINISTRATION, WELL PROGRAM

DATE WELL ABANDONED: 2-26-25 (month/day/year)

* PERMIT NUMBER OF ABANDONED WELL (if any) [illegible] 3/11/25 [illegible]

* PERMIT NUMBER OF REPLACEMENT WELL:

* PERSON ABANDONING WELL: [illegible] WELL DRILLER'S LICENSE NUMBER: 151
CIRCLE: MWD / MSD / MGD

* OWNER'S NAME: [illegible]

* WELL LOCATION:
COUNTY: Harford
NEAREST TOWN: [illegible]
TAX MAP 31 BLOCK ____ PARCEL 361
SUBDIVISION: 1001
SECTION: ____ LOT: ____
STREET ADDRESS: 4850 [illegible] Ln

LATITUDE 3 9 . 2 3 8 2 5 9

LONGITUDE 7 6 . 7 7 5 3 9 4

* Well abandoned b/c [illegible]

* TYPE OF WELL BEING ABANDONED:
____ DRILLED ____ JETTED
____ BORED ____ HAND DUG
____ OTHER (specify)____

* USE CODE:
X DOMESTIC ____ MUNICIPAL/PUBLIC
____ IRRIGATION ____ INDUSTRIAL
____ TEST/OBSERVATION ____ GEOTHERMAL

* TYPE OF CASING:
X STEEL ____ PLASTIC
____ CONCRETE ____ OTHER (specify)

SIZE OF CASING: 5 INCHES IN DIAMETER

DEPTH OF WELL: 80 FEET DEEP

WAS ANY CASING REMOVED? X YES ____ NO
If yes, length removed, in feet: 3

WAS CASING RIPPED OR PERFORATED? ____ YES X NO

SITE LOCATION MAP

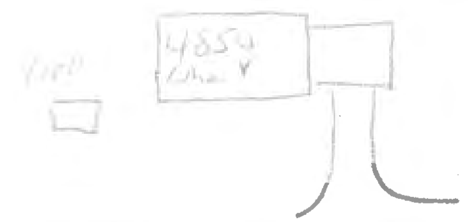

LOG OF SEALING MATERIAL

MATERIAL	FEET	
	FROM	TO
Soil Clay	80	3

VOLUME OF MATERIAL USED

95 Gallons Bentonite

Pursuant to § 10-624 of the State Govt. Article of the Maryland Code, personal info requested on this form is used in processing this form pursuant to COMAR 26.04.04. Failure to provide the info may result in this form not being processed. You have the right to inspect, amend, or correct this form. The Maryland Department of the Environment is subject to the Maryland Public Information Act. This form may be made available on the Internet via MDE's website and is subject to inspection or copying, in whole or in part, by the public and other governmental agencies, if not protected by federal or State Law.

[signature] 553 (MWD) / MSD / MGS 2/26/25

SIGNATURE-MASTER WELL DRILLER OR SUPERVISING SANITARIAN LICENSE# CIRCLE ONE DATE

COUNTY