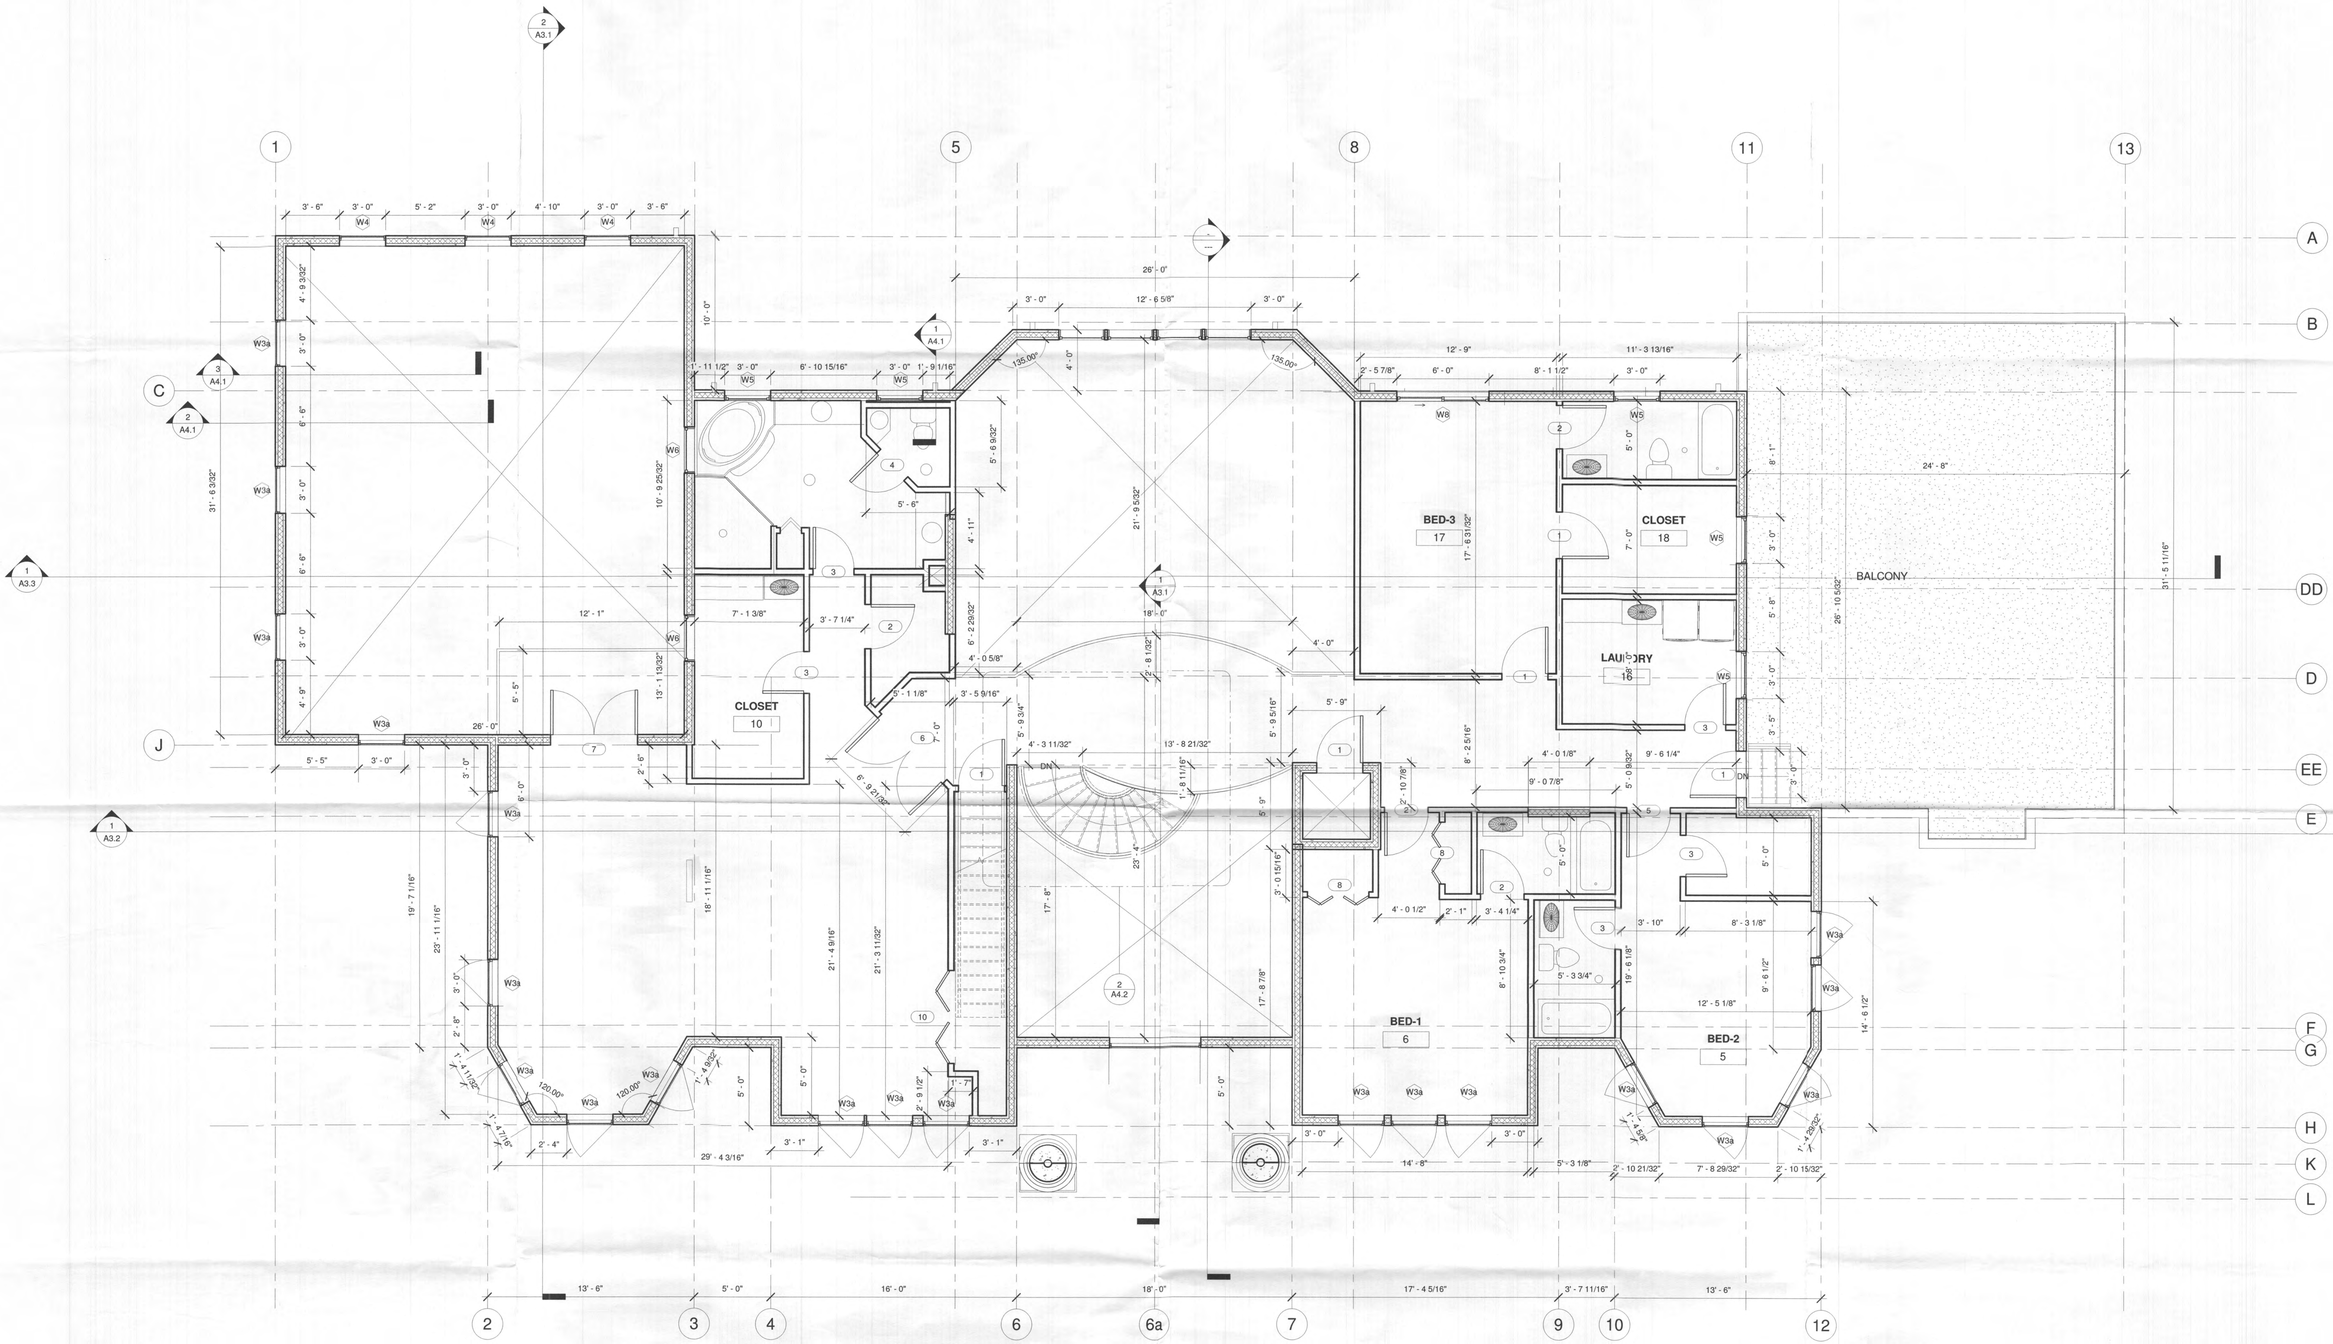


1 SECOND FLOOR PLAN
1/4" = 1'-0"

WASHINGTON AREA OFFICE
8101 Sandy Spring Rd.
Suite 105
Laurel, MD. 20707
phone 301.513.0600
fax 301.513.0155

© SAA ARCHITECTURE LLC. 2017
This drawing may be utilized only for the purpose of constructing or installing the work shown thereon at the site of the work specified. Any other use of this drawing, including without limitation any reproduction or alteration of this drawing, without the prior written approval of SAA Architecture LLC. is prohibited.

SAA
ARCHITECTURE LLC.
Architecture / Planning
Striking, Functional,
Innovative Architecture
www.DesignedToLast.com

It is the intent of these drawings & specifications to produce a complete project. In all cases the drawings & specifications must be reviewed, priced, estimated, and constructed in their entirety. The drawings are complementary to one another & the specifications. Anything shown or implied on any one drawing must be provided, installed and connected as though it was shown on all drawings and included in the original pricing. No request for additional cost, or change orders will be accepted by The owner from any contractor, subcontractor, supplier or installer that result from a failure to thoroughly review ALL the drawings, coordination with other trades, or thoroughly inspect the site to determine all existing conditions.

SIDDIQI RESIDENCE

4890 Castlebridge Rd Ellicott
City, MD 21042


"Professional Certification. I here by certify that these documents were prepared or approved by me, and that I am a duly licensed Professional Architect under the laws of the state of Maryland, License No. 3329-A, Expiration Date: 9/14/2018"

ARCHITECTURAL REGISTRATION BOARD
R. GLEN STEPHENS
3329-A
STATE OF MARYLAND

SHEET STATUS			
NAME	DATE	HGR	RELEASE

SECOND FLOOR PLAN

DRAWN BY: Author
CHK'D BY: Checker
JOB NO.: Project Number
SHEET NO.: A1.2

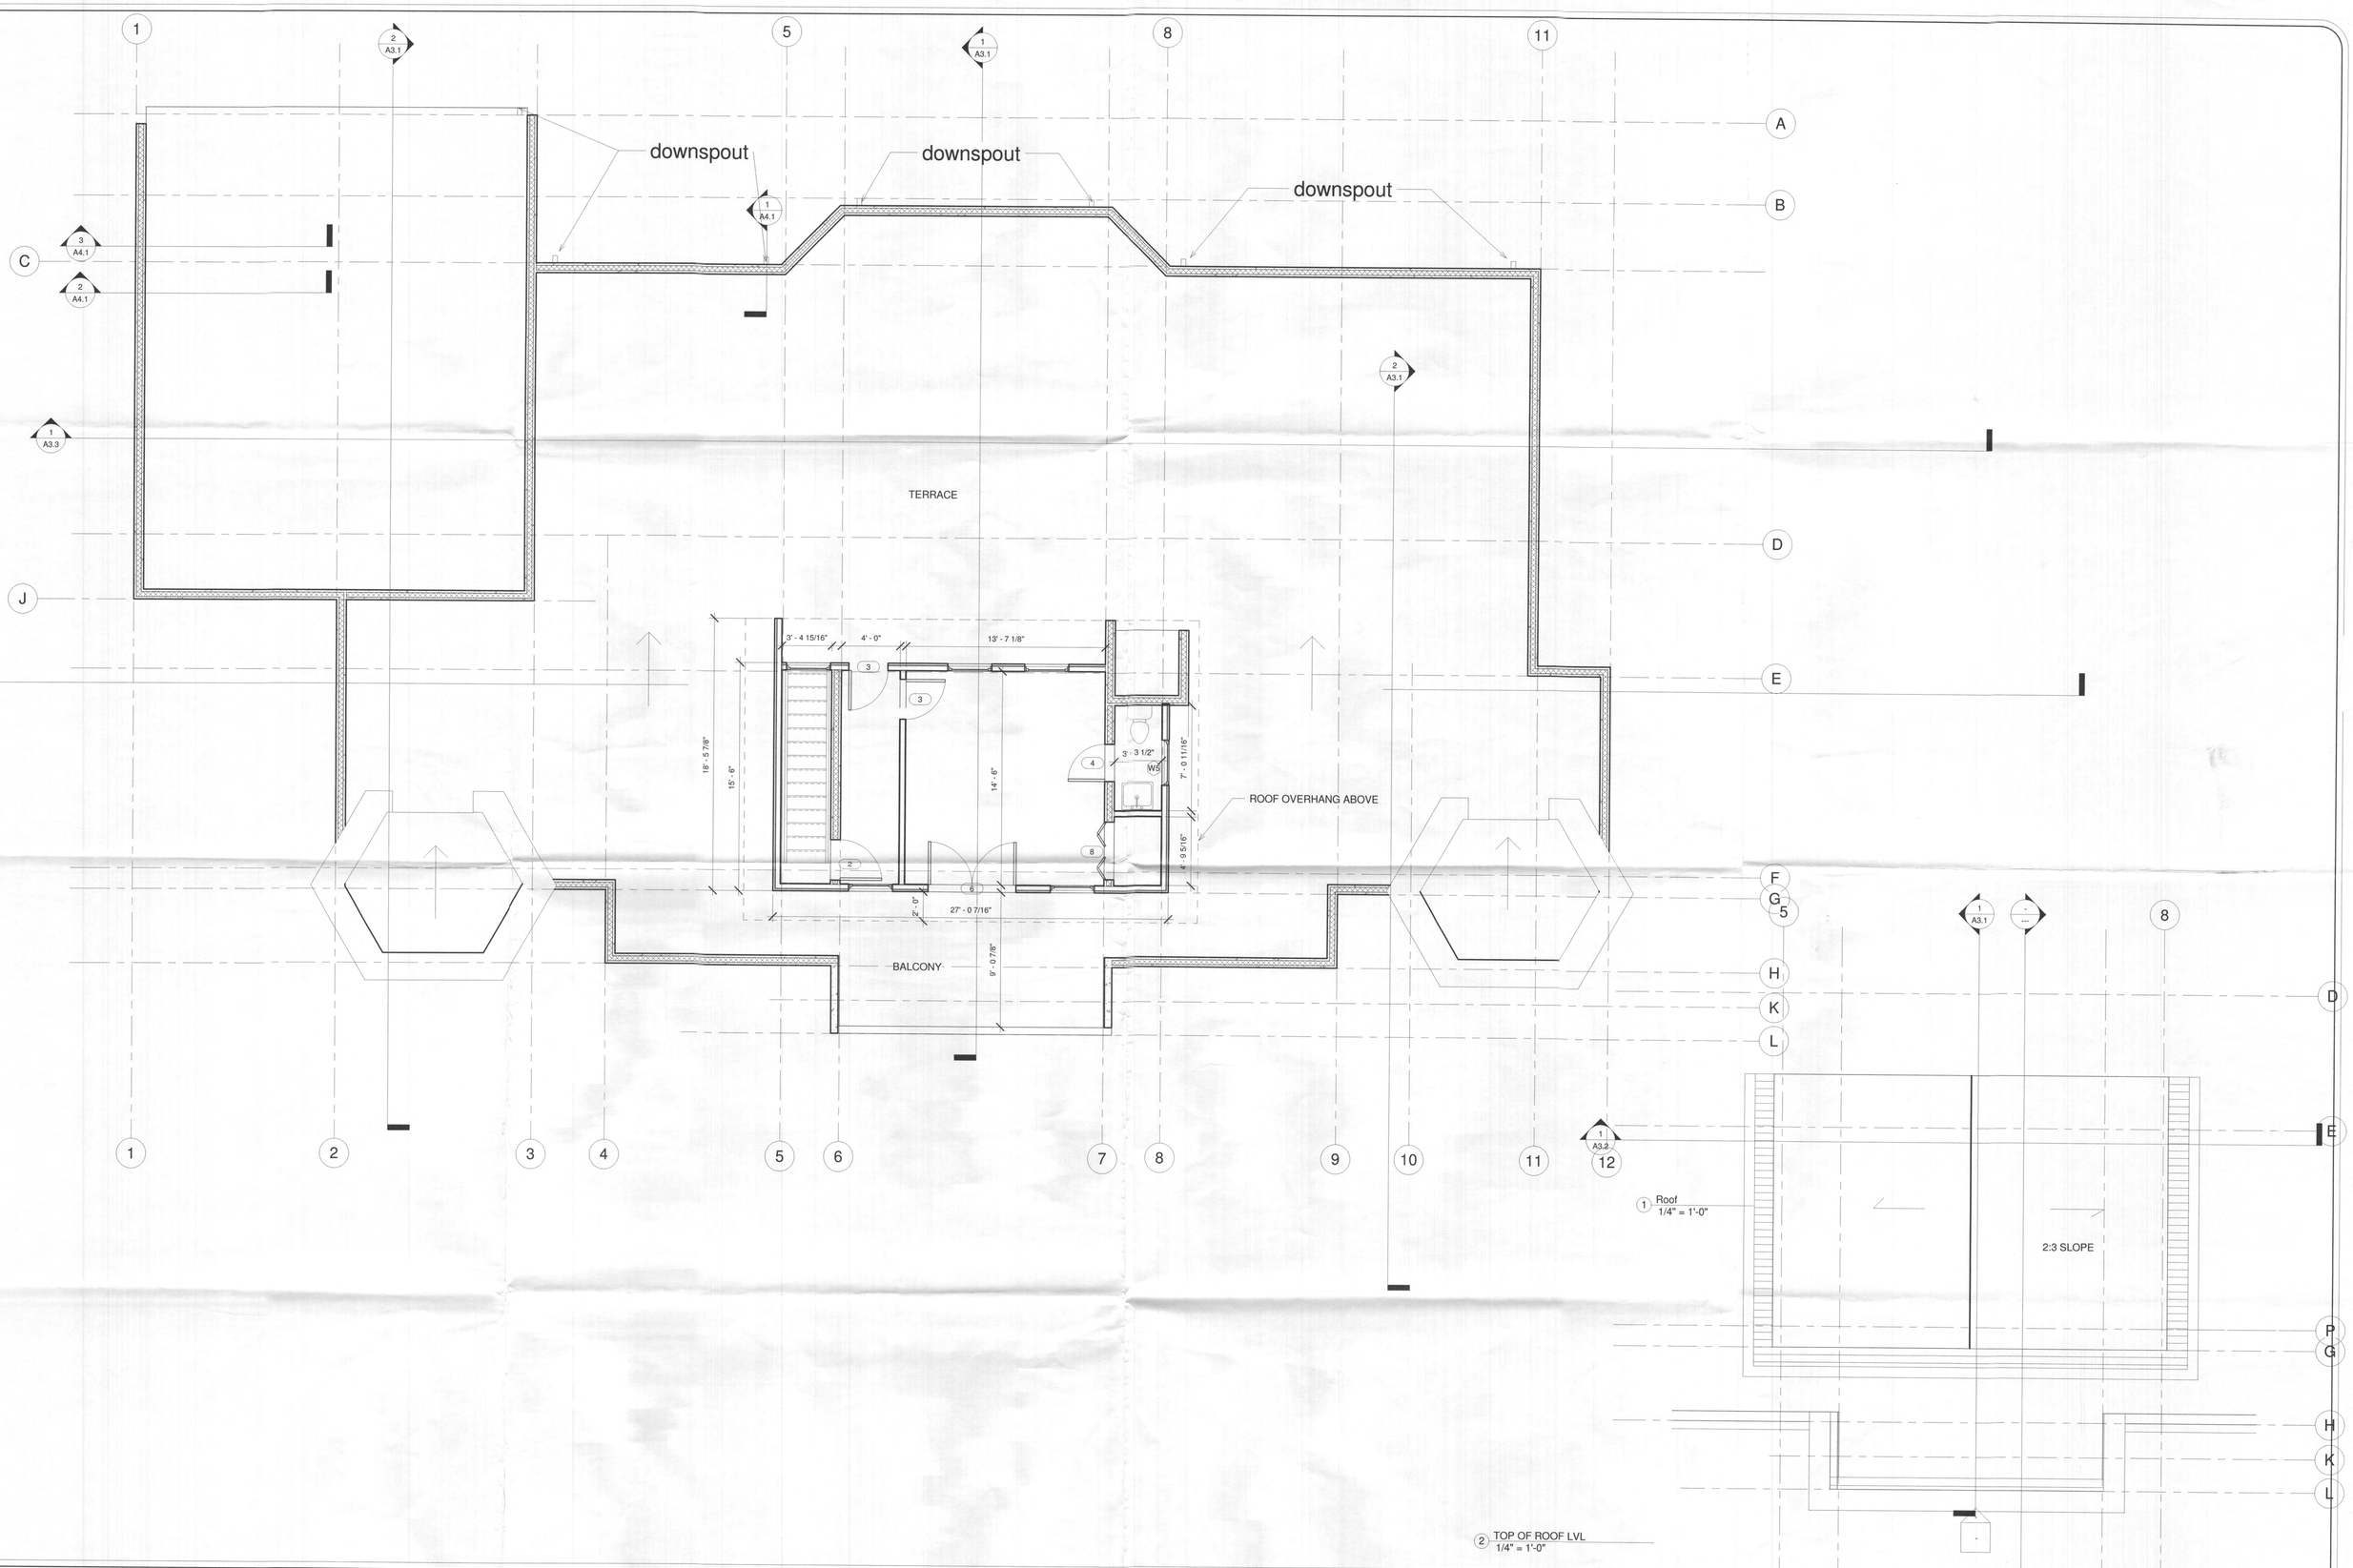

1 Roof
1/4" = 1'-0"

2 TOP OF ROOF LVL
1/4" = 1'-0"

WASHINGTON AREA OFFICE
8101 Sandy Spring Rd.
Suite 105
Laurel, MD. 20707
phone 301.513.0600
fax 301.513.0155

© SAA ARCHITECTURE LLC. 2017
This drawing may be utilized only for the purpose of constructing or installing the work shown thereon at the site of the work specified. Any other use of this drawing, including without limitation any reproduction or alteration of this drawing, without the prior written approval of SAA Architecture LLC. is prohibited.

SAA
ARCHITECTURE LLC.
Architecture / Planning
Striking, Functional,
Innovative Architecture
www.DesignedToLast.com

It is the intent of these drawings & specifications to produce a complete project. In all cases the drawings & specifications must be reviewed, priced, estimated, and constructed in their entirety. The drawings are complementary to one another & the specifications. Anything shown or implied on any one drawing must be provided, installed and connected as though it was shown on all drawings and included in the original pricing. No request for additional cost, or change orders will be accepted by The owner from any contractor, subcontractor, supplier or installer that result from a failure to thoroughly review ALL the drawings, coordination with other trades, or thoroughly inspect the site to determine all existing conditions.

SIDDIQI RESIDENCE
4890 Castlebridge Rd Ellicott
City, MD 21042

"Professional Certification. I here by certify that these documents were prepared or approved by me, and that I am a duly licensed Professional Architect under the laws of the state of Maryland, License No. 3329-A, Expiration Date: 9/14/2018"


ARCHITECTURAL REGISTRATION BOARD
R. GLEN STEPHENS
3329-A
STATE OF MARYLAND

SHEET STATUS

NO.	DATE	REVISION	RELEASE
7			

ROOF PLAN

DRAWN BY: Author
CHK'D BY: Checker
JOB NO.: Project Number
SHEET NO.: A1.3

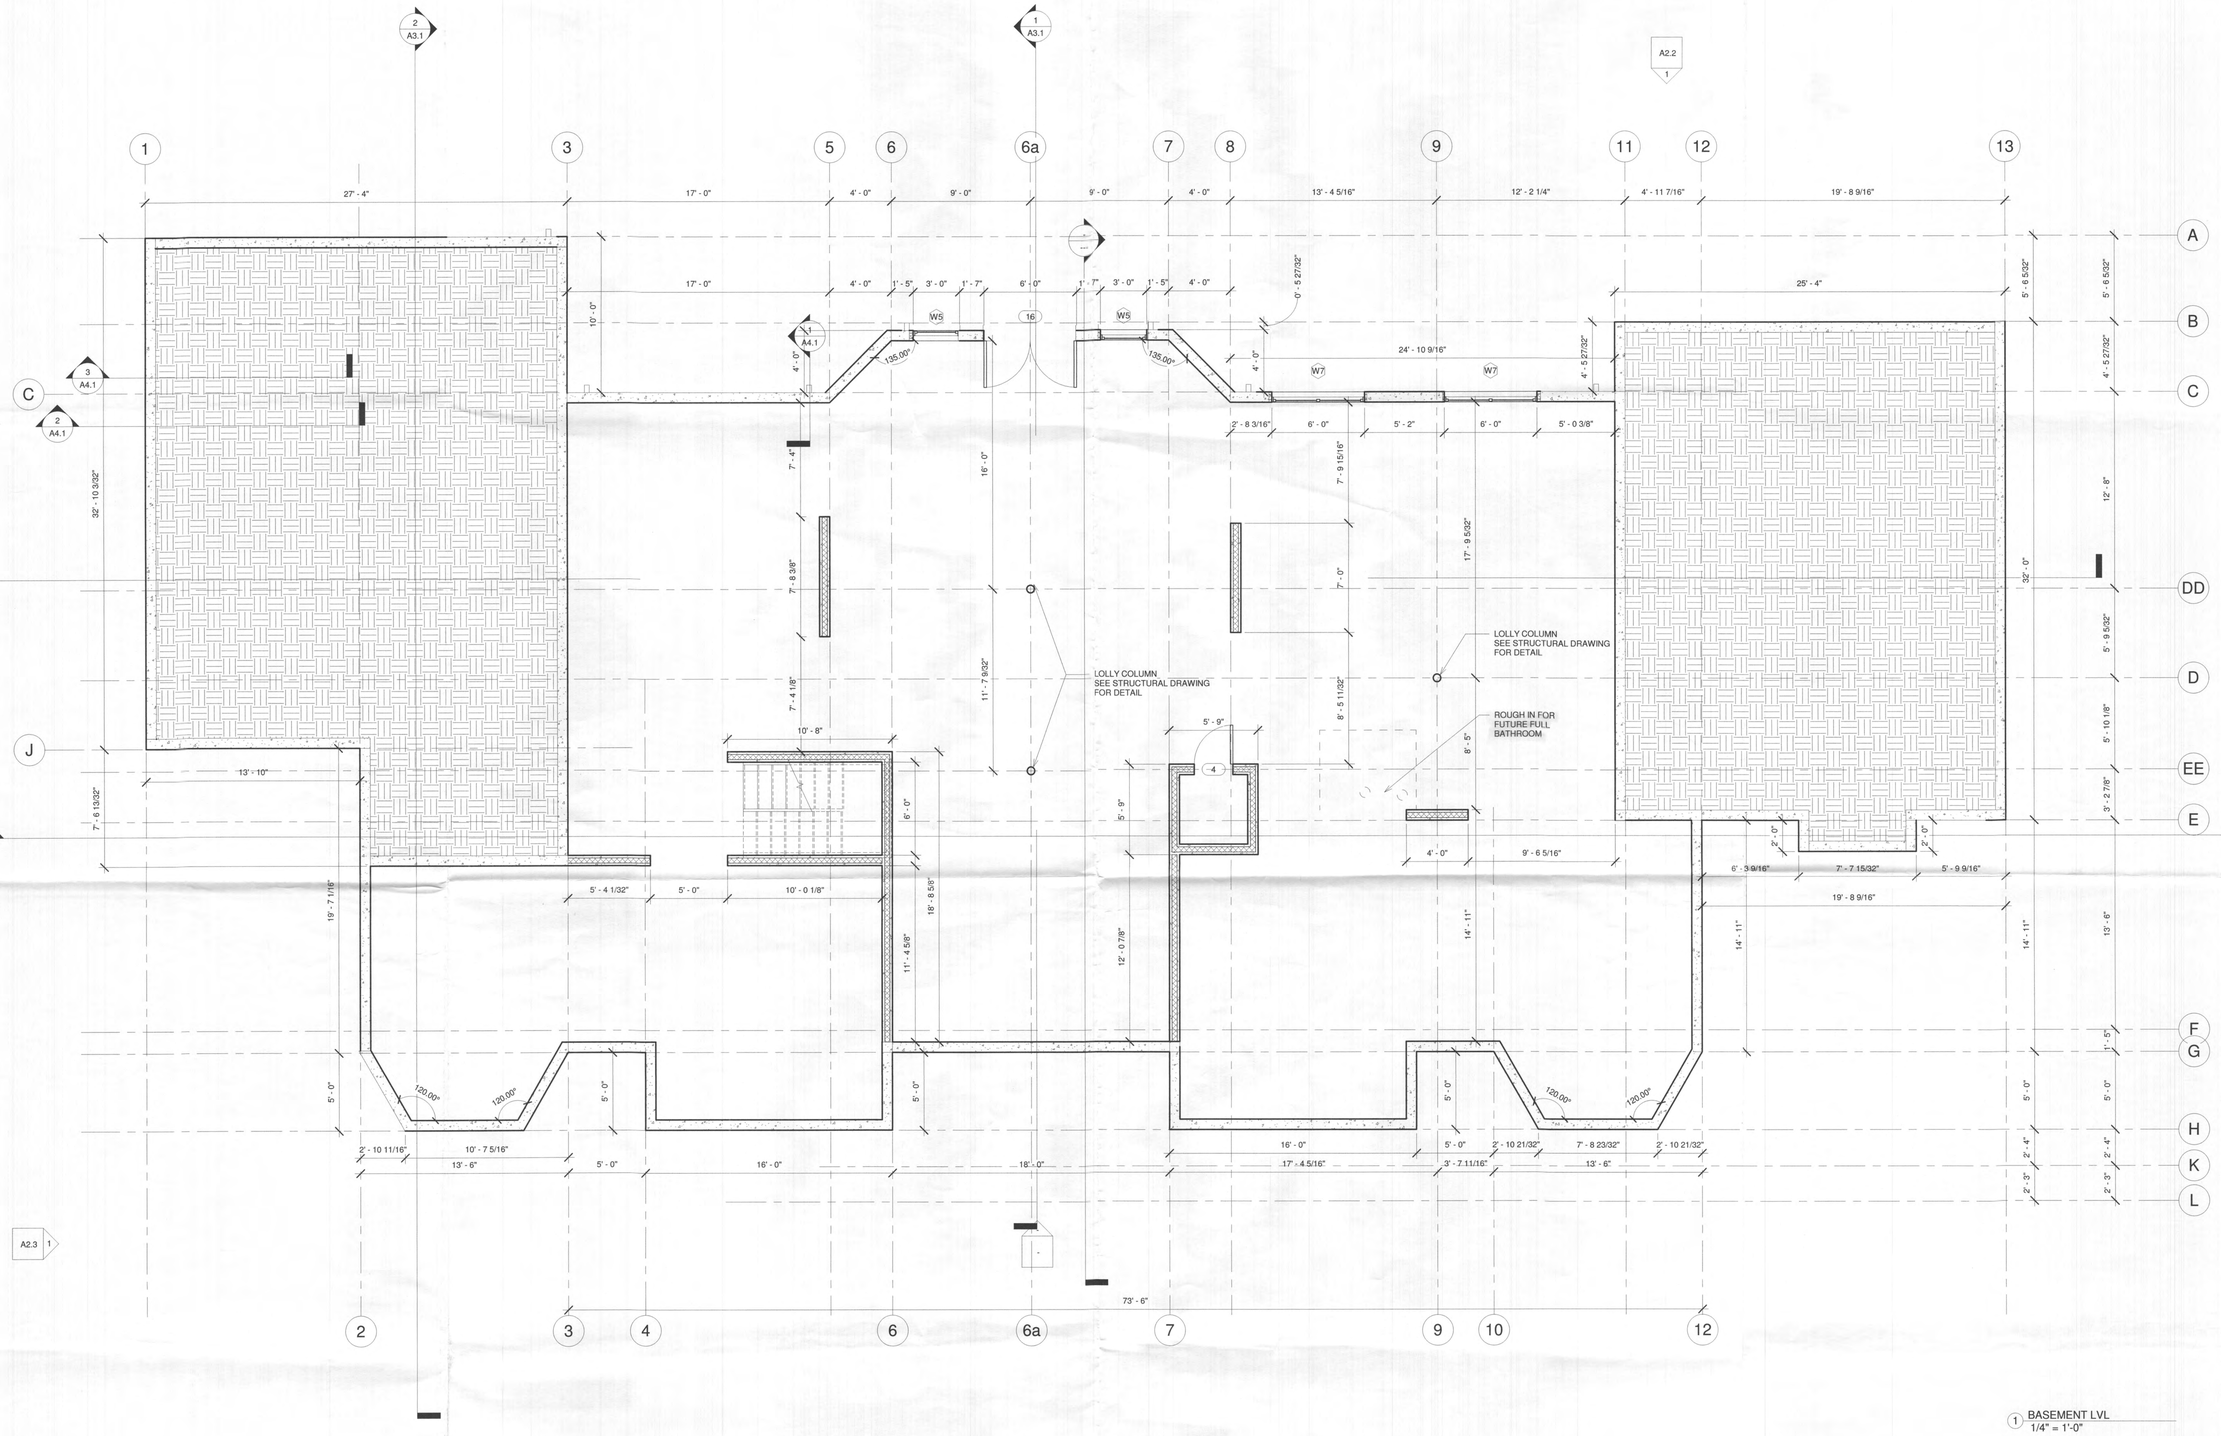

1 BASEMENT LVL
1/4" = 1'-0"

WASHINGTON AREA OFFICE
8101 Sandy Spring Rd.
Suite 105
Laurel, MD. 20707
phone 301.513.0600
fax 301.513.0155

© SAA ARCHITECTURE LLC. 2017
This drawing may be utilized only for the purpose of constructing or installing the work shown thereon at the site of the work specified. Any other use of this drawing, including without limitation any reproduction or alteration of this drawing, without the prior written approval of SAA Architecture LLC. is prohibited.

SAA
ARCHITECTURE LLC.
Architecture / Planning
Striking, Functional,
Innovative Architecture
www.DesignedToLast.com

It is the intent of these drawings & specifications to produce a complete project. In all cases the drawings & specifications must be reviewed, priced, estimated, and constructed in their entirety. The drawings are complementary to one another & the specifications. Anything shown or implied on any one drawing must be provided, installed and connected as though it was shown on all drawings and included in the original pricing. No request for additional cost, or change orders will be accepted by The owner from any contractor, subcontractor, supplier or installer that result from a failure to thoroughly review ALL the drawings, coordination with other trades, or thoroughly inspect the site to determine all existing conditions.

SIDDIQI RESIDENCE
4890 Castlebridge Rd Ellicott
City, MD 21042

"Professional Certification. I here by certify that these documents were prepared or approved by me, and that I am a duly licensed Professional Architect under the laws of the state of Maryland, License No. 3329-A, Expiration Date: 9/14/2018"


ARCHITECTURAL REGISTRATION BOARD
STEPHEN STEPHENS
3329-A
STATE OF MARYLAND

SHEET STATUS

MARK	DATE	PAGE	RELEASE

BASEMENT PLAN

DRAWN BY: Author
CHK'D BY: Checker
JOB NO.: Project Number
SHEET NO.: A1.4

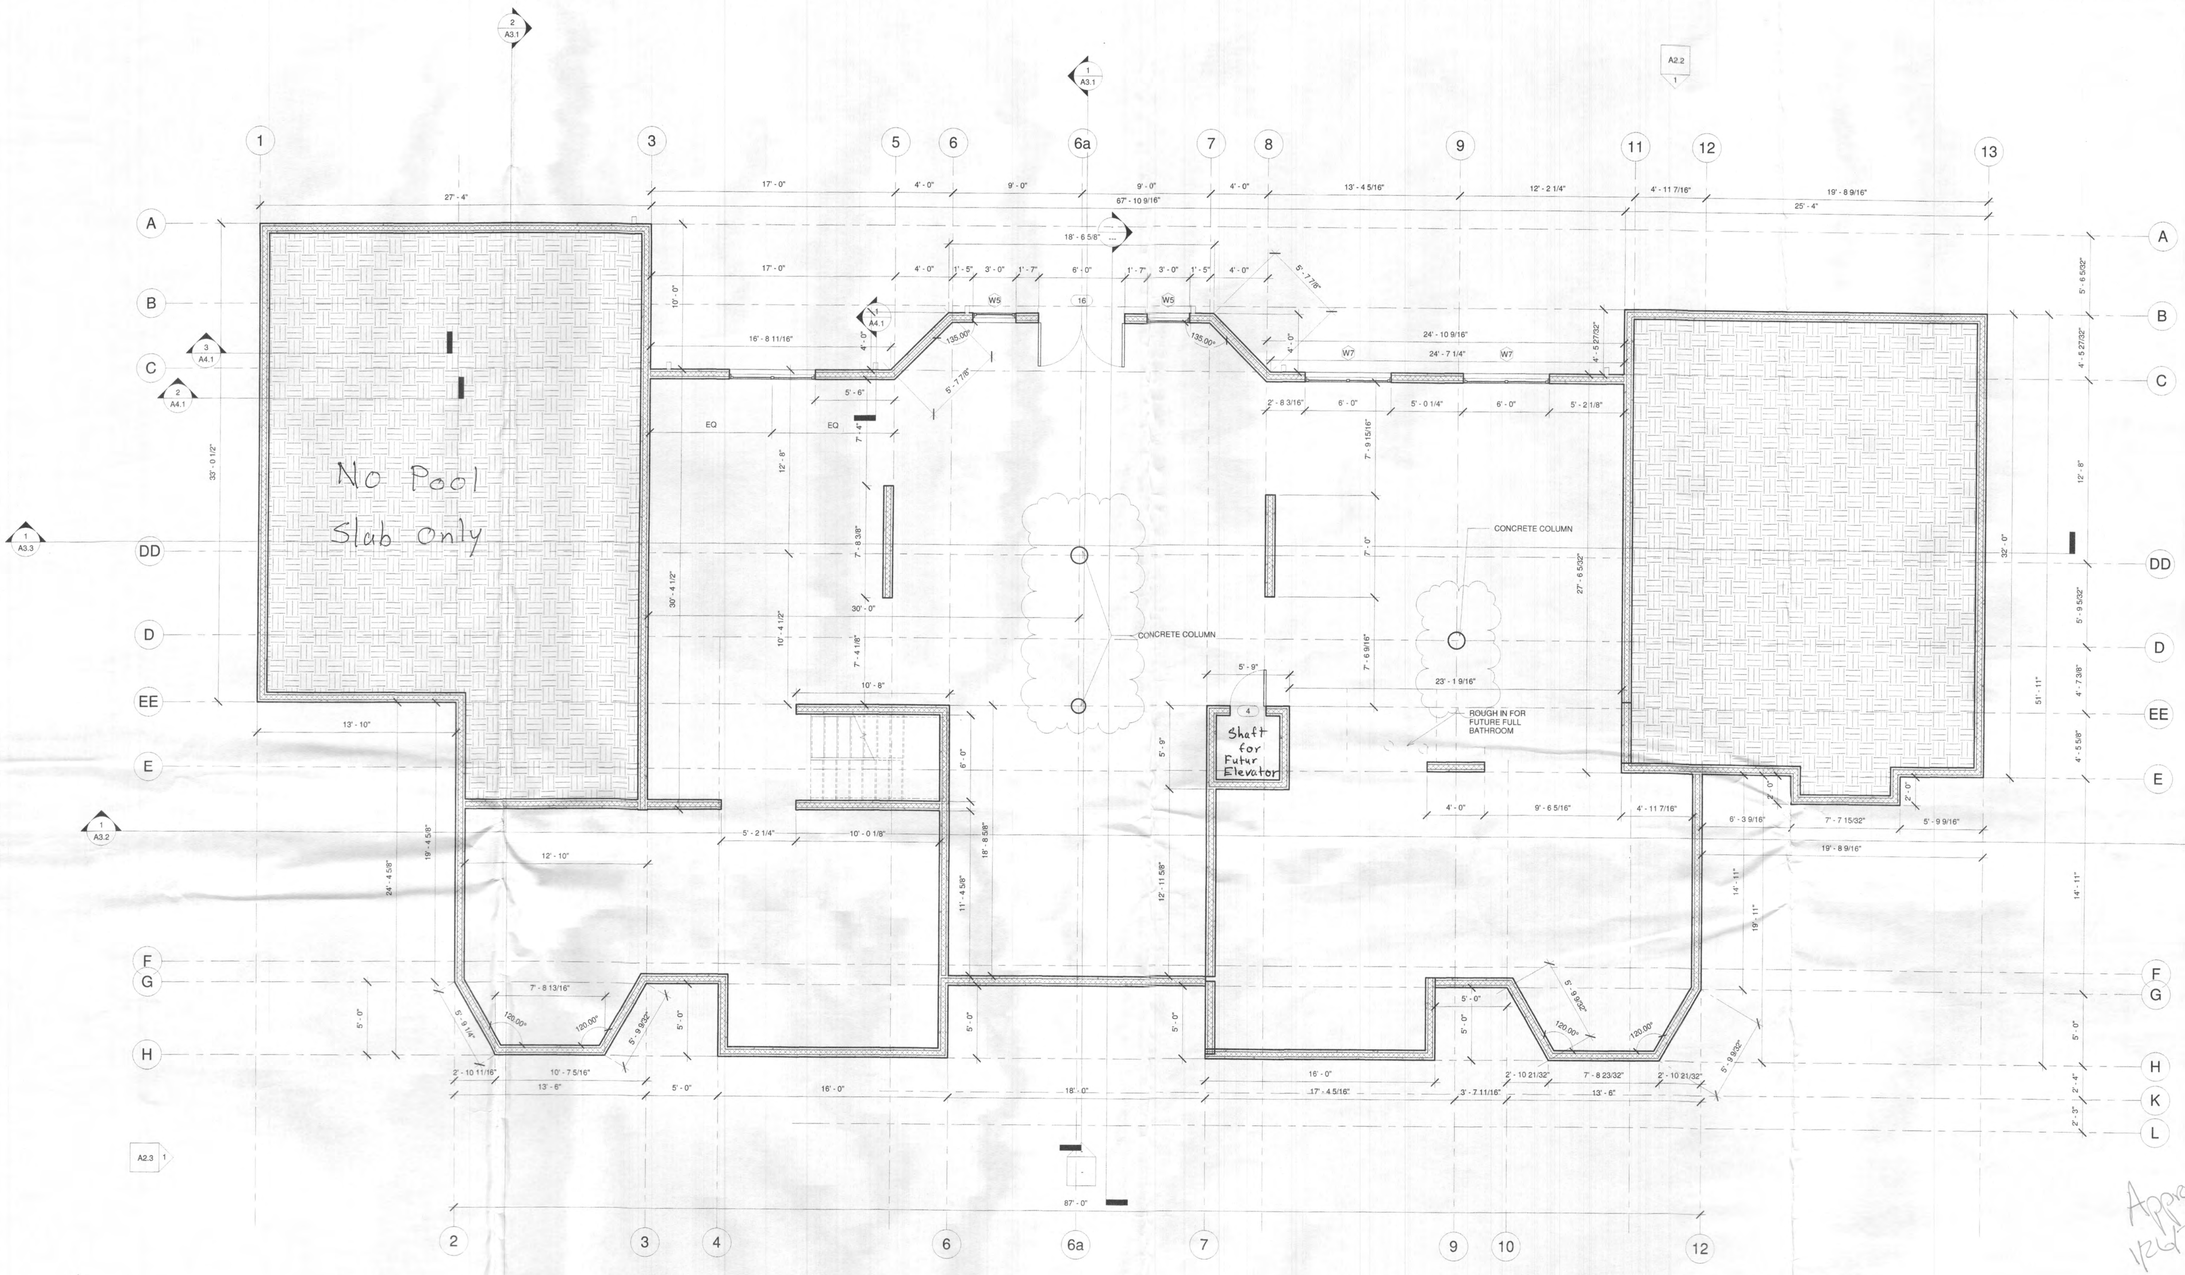

Approved
12/4/2024 RTE

Approval for foundation change. See attach letter

REVIEWED FOR CODE COMPLIANCE

FOOTING TO BE CONTINUED BY ENGINEER

REVISED
Date:
Comments: 11/16/18

REVISED
Date: 12.29.23
Comments: B18001872

WASHINGTON AREA OFFICE
8101 Sandy Spring Rd.
Suite 105
Laurel, MD. 20707
phone 301.513.0600
fax 301.513.0155

© SAA ARCHITECTURE LLC. 2017
This drawing may be utilized only for the purpose of constructing or installing the work shown thereon at the site of the work specified. Any other use of this drawing, including without limitation any reproduction or alteration of this drawing, without the prior written approval of SAA Architecture LLC. is prohibited.

SAA
ARCHITECTURE LLC.
Architecture / Planning
Striking, Functional,
Innovative Architecture
www.DesignedToLast.com

It is the intent of these drawings & specifications to produce a complete project. In all cases the drawings & specifications must be reviewed, priced, estimated, and constructed in their entirety. The drawings are complementary to one another & the specifications. Anything shown or implied on any one drawing must be provided, installed and connected as though it was shown on all drawings and included in the original pricing. No request for additional cost, or change orders will be accepted by The owner from any contractor, subcontractor, supplier or installer that result from a failure to thoroughly review ALL the drawings, coordination with other trades, or thoroughly inspect the site to determine all existing conditions.

SIDDIQI RESIDENCE

Castlebridge Rd Ellicott City,
MD 21042


"Professional Certification.
I hereby certifythat these documents were prepared or approved by me, and that I am a duly licensed Professional Architect under the laws of the state of Virginia,
License No. 0401006608,
Expiration Date: 11/30/2019"

SHEET STATUS

MARK	DATE	ISSUE	RELEASE

BASEMENT PLAN

DRAWN BY: Author
CHK'D BY: Checker
JOB NO.: Project Number
SHEET NO.: A1.4

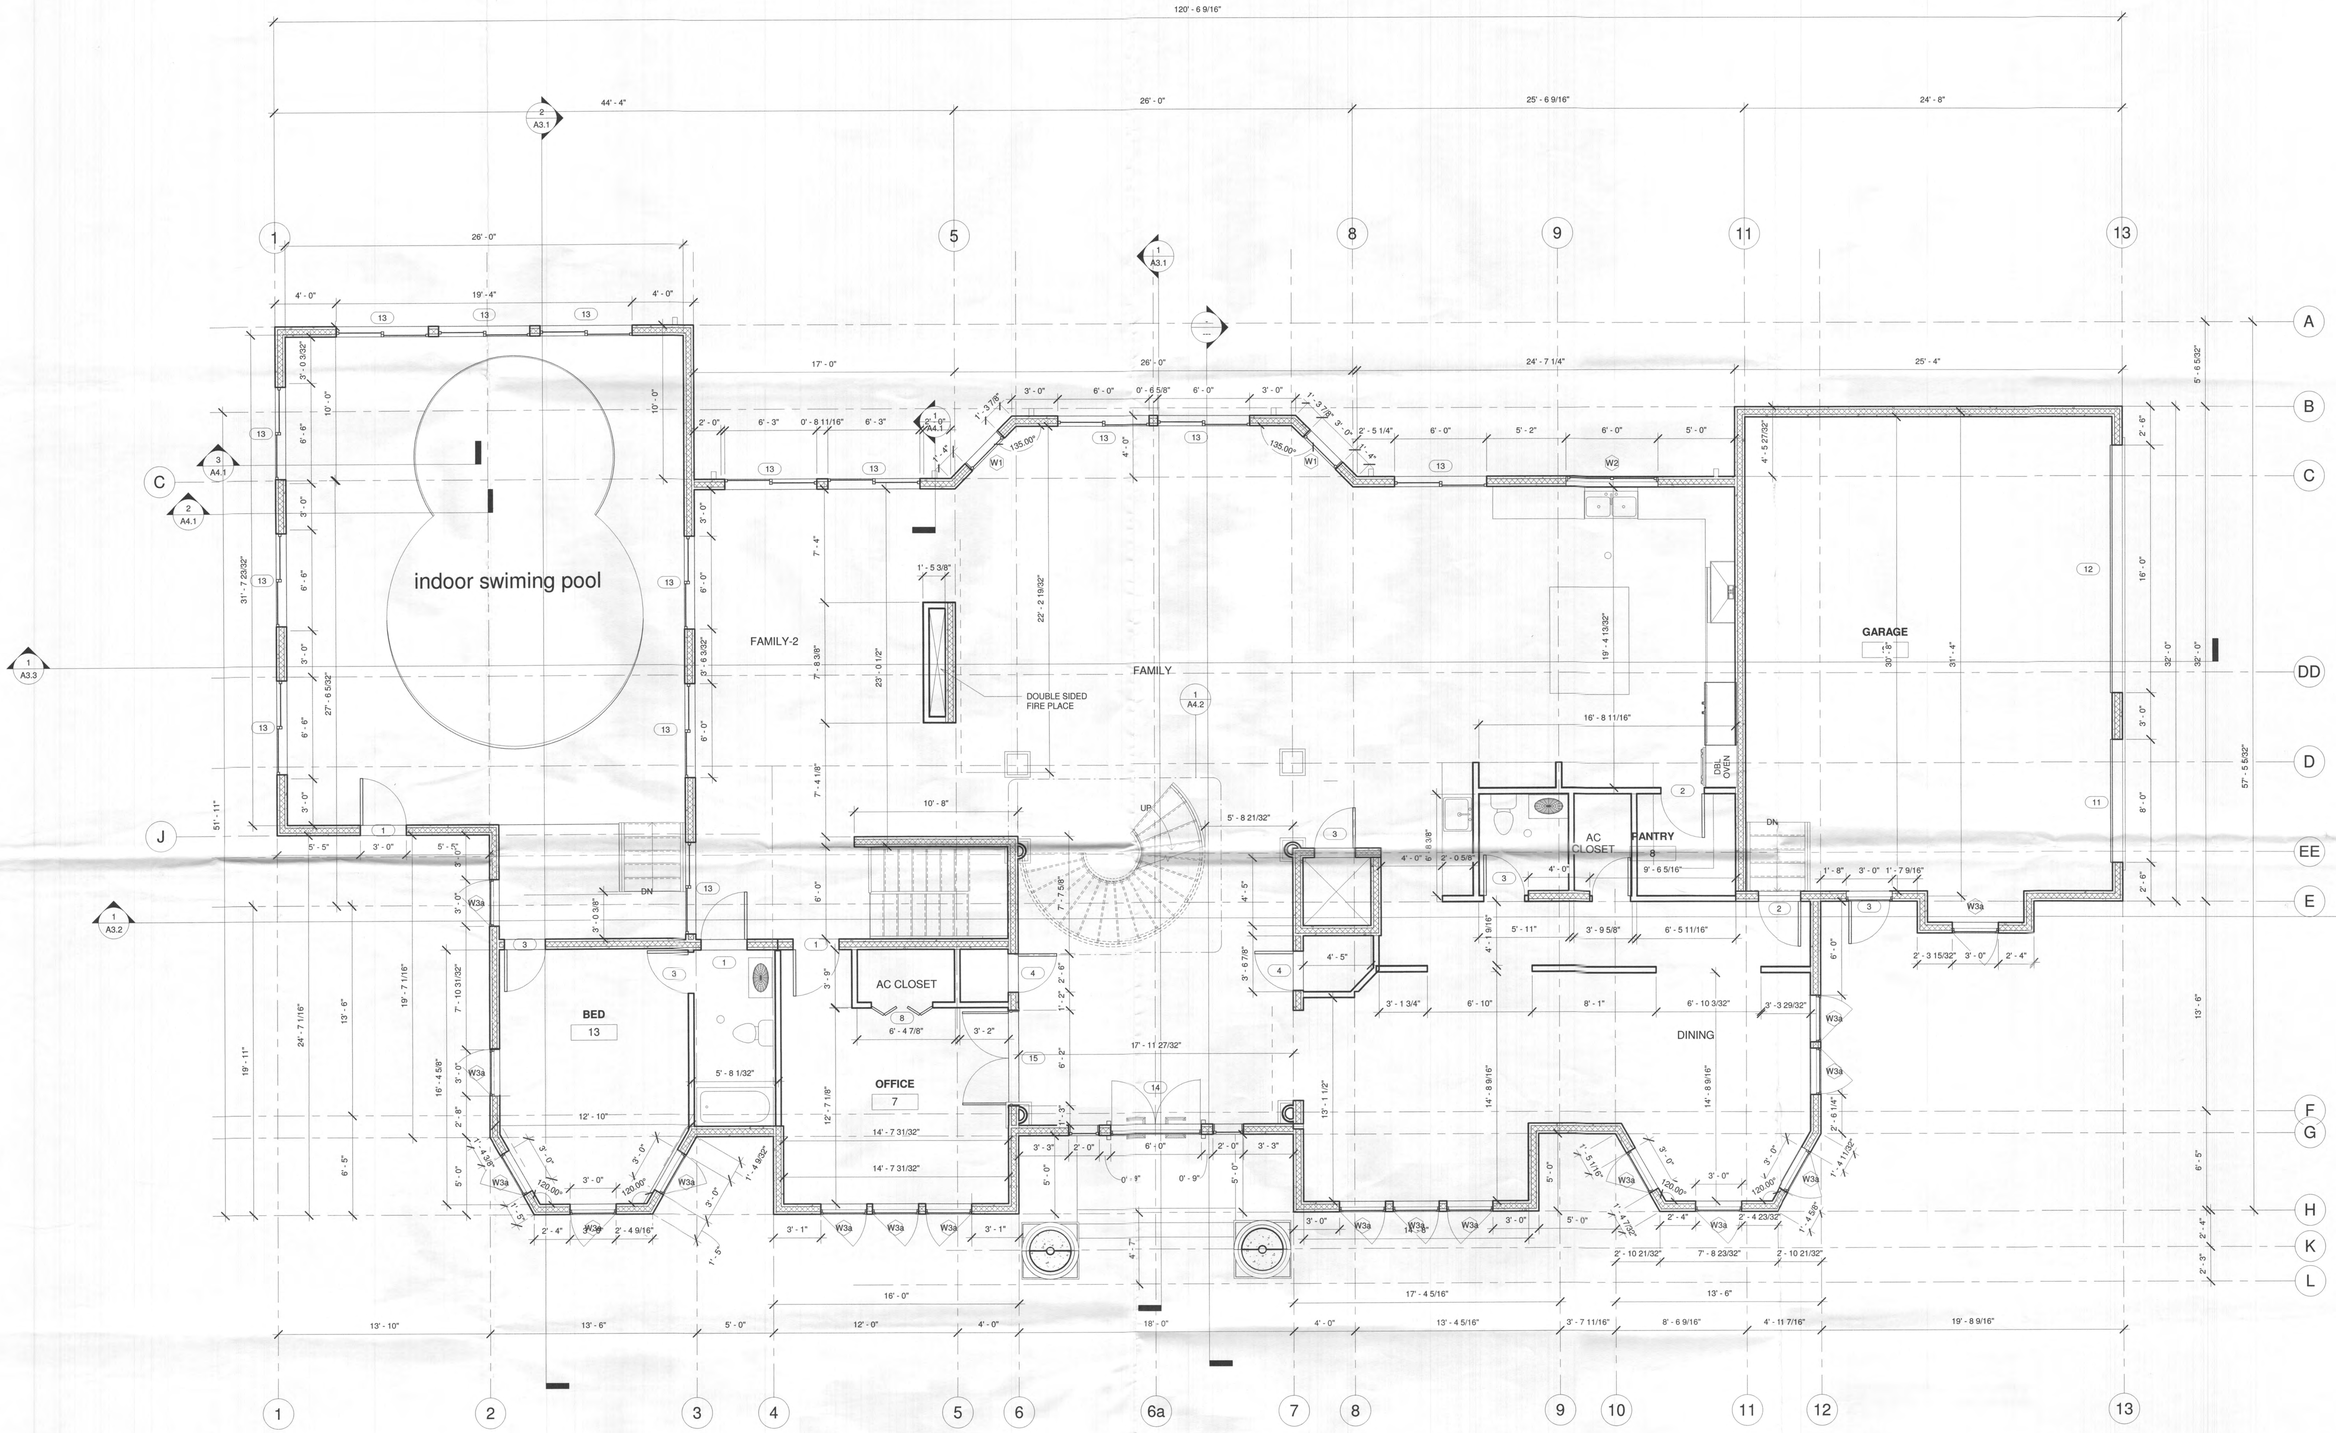

1 FIRST FLOOR PLAN
1/4" = 1'-0"

WASHINGTON AREA OFFICE
8101 Sandy Spring Rd.
Suite 105
Laurel, MD. 20707
phone 301.513.0600
fax 301.513.0155

© SAA ARCHITECTURE LLC. 2017
This drawing may be utilized only for the purpose of constructing or installing the work shown thereon at the site of the work specified. Any other use of this drawing, including without limitation any reproduction or alteration of this drawing, without the prior written approval of SAA Architecture LLC. is prohibited.

SAA
ARCHITECTURE LLC.
Architecture / Planning
Striking, Functional,
Innovative Architecture
www.DesignedToLast.com

It is the intent of these drawings & specifications to produce a complete project. In all cases the drawings & specifications must be reviewed, priced, estimated, and constructed in their entirety. The drawings are complementary to one another & the specifications. Anything shown or implied on any one drawing must be provided, installed and connected as though it was shown on all drawings and included in the original pricing. No request for additional cost, or change orders will be accepted by The owner from any contractor, subcontractor, supplier or installer that result from a failure to thoroughly review ALL the drawings, coordination with other trades, or thoroughly inspect the site to determine all existing conditions.

SIDDIQI RESIDENCE

4890 Castlebridge Rd Ellicott
City, MD 21042

"Professional Certification. I here by certify that these documents were prepared or approved by me, and that I am a duly licensed Professional Architect under the laws of the state of Maryland, License No. 3329-A, Expiration Date: 9/14/2018"

ARCHITECTURAL REGISTRATION BOARD
E. ALAN STEPHENS
3329-A
STATE OF MARYLAND

SHEET STATUS			
MARK	DATE	MGR	RELEASE

FIRST FLOOR PLAN

DRAWN BY:	Author
CHK'D BY:	Checker
JOB NO.:	Project Number
SHEET NO.:	A1.1