
 WATER WELL ABANDONMENT-SEALING REPORT FORM

SUBMIT COPIES OF COMPLETED FORM TO:

- * COUNTY ENVIRONMENTAL AGENCY (contact MDE, WMA if address needed)
- * WELL OWNER
- * MDE, WATER MANAGEMENT ADMINISTRATION, WELL PROGRAM

OK
 11/26/24
 (SP)

DATE WELL ABANDONED: 10/30/24 (month/day/year)

* PERMIT NUMBER OF ABANDONED WELL (if any) _____

No tag

* PERMIT NUMBER OF REPLACEMENT WELL: _____


* PERSON ABANDONING WELL: Andrew Houseman WELL DRILLER'S LICENSE NUMBER: 224

CIRCLE: MWD / MSD / MGD

* OWNER'S NAME: J & A Construction

SITE LOCATION MAP

* WELL LOCATION:
 COUNTY: Howard
 NEAREST TOWN: Ellicott City
 TAX MAP 31 BLOCK 4 PARCEL 618
 SUBDIVISION: Oak Hill Manor
 SECTION: _____ LOT: 6
 STREET ADDRESS: 4972 Ilchester Rd

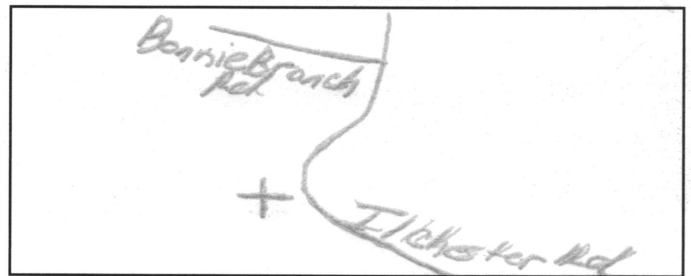

LATITUDE 3 9.248209

LONGITUDE 7 6.769163

LOG OF SEALING MATERIAL

* TYPE OF WELL BEING ABANDONED:
 _____ DRILLED _____ JETTED
 _____ BORED _____ HAND DUG
 _____ OTHER (specify) _____

MATERIAL	FEET	
	FROM	TO
<u>stone</u>	<u>50</u>	<u>8</u>
<u>Concrete</u>	<u>8</u>	<u>2</u>

* USE CODE:
 DOMESTIC _____ MUNICIPAL/PUBLIC
 _____ IRRIGATION _____ INDUSTRIAL
 _____ TEST/OBSERVATION _____ GEOTHERMAL

VOLUME OF MATERIAL USED
Stone 15yds Concrete 1.5yds

* TYPE OF CASING:
 _____ STEEL _____ PLASTIC
 _____ CONCRETE _____ OTHER (specify)
stone

SIZE OF CASING: 3.5 INCHES IN DIAMETER

DEPTH OF WELL: 50 FEET DEEP

WAS ANY CASING REMOVED? _____ YES NO
 If yes, length removed, in feet: _____

WAS CASING RIPPED OR PERFORATED? _____ YES _____ NO

SIGNATURE-MASTER WELL DRILLER OR SUPERVISING SANITARIAN LICENSE# _____

Andrew Houseman

224 MWD / MSD / MGS
 CIRCLE ONE

10-30-24 DATE

COUNTY

Pursuant to § 10-624 of the State Govt. Article of the Maryland Code, personal info requested on this form is used in processing this form pursuant to COMAR 26.04.04. Failure to provide the info may result in this form not being processed. You have the right to inspect, amend, or correct this form. The Maryland Department of the Environment is subject to the Maryland Public Information Act. This form may be made available on the Internet via MDE's website and is subject to inspection or copying, in whole or in part, by the public and other governmental agencies, if not protected by federal or State Law.