DNR-213

C 1 5560 — SEQUENCE NO. (WRA USE ONLY) — (SEQ. NO.) — (THIS NUMBER IS TO BE PUNCHED IN COLS. 3-6 ON ALL CARDS)

STATE OF MARYLAND
WATER RESOURCES ADMINISTRATION
TAWES STATE OFFICE BLDG., ANNAPOLIS, MD. 21401
WELL COMPLETION REPORT

THIS REPORT MUST BE SUBMITTED WITHIN 30 DAYS AFTER WELL COMPLET

FILL IN THIS FORM COMPLETELY

COUNTY NUMBER

DATE RECEIVED (WRA USE ONLY) 8-13

DATE WELL COMPLETED 5/4/79 (15–20)

DEPTH OF WELL 272 (TO NEAREST FOOT) (22–26)

PERMIT NO. FROM "PERMIT TO DRILL WELL": H0-73-3189 (28–37)

DRILLERS IDENTIFICATION NO. 154

OWNER: LAST NAME SIEGEL — FIRST NAME CARLIE

STREET OR RFD 6003 ARBUTUS AVE — POST OFFICE BALTO-MD. 21227

WELL DESCRIPTION

WELL LOG

STATE THE KIND OF FORMATIONS PENETRATED, THEIR COLOR, DEPTH, THICKNESS AND IF WATER BEARING

DESCRIPTION (USE ADDITIONAL SHEETS IF NECESSARY)	FEET FROM	FEET TO	CHECK IF WATER BEARING
MARBLE CLAY	0	8	
SAND ROCK & SAND	8	20	
SAND ROCK	20	35	
GREY CLAY	35	45	
GRANITE ROCK	45	272	Y

GROUTING RECORD

WELL HAS BEEN GROUTED (CIRCLE APPROPRIATE BOX) — YES (Y) — NO (N) (44)

TYPE OF GROUTING MATERIAL (CIRCLE BOX): CEMENT (C M) (45 46) — BENTONITE CLAY (B C) (45 46)

NO. OF BAGS 10 — NO. OF POUNDS

GALLONS OF WATER 60

DEPTH OF GROUT SEAL (TO NEAREST FOOT)

FROM 0 FT. TO 46 FT. (48–52 / 54–58)

(ENTER 0 IF FROM SURFACE)

CASING RECORD

CASING TYPES — INSERT APPROPRIATE CODE BELOW

ST STEEL — CO CONCRETE — PL PLASTIC — OT OTHER

MAIN CASING TYPE: ST (60–61) — NOMINAL DIAMETER TOP (MAIN) CASING (NEAREST INCH): 6 (63–64) — TOTAL DEPTH OF MAIN CASING (NEAREST FOOT): 46 (66–70)

OTHER CASING (IF USED)

EACH CASING — DIAMETER (INCH) — DEPTH (FEET) FROM — TO

SCREEN RECORD

SCREEN TYPE OR OPEN HOLE — INSERT APPROPRIATE CODE BELOW

ST STEEL — BR BRASS OR BRONZE — HO OPEN HOLE — PL PLASTIC — OT OTHER

C 2 (1–3) (SEQ. NO.) (6)

EACH SCREEN — DEPTH (NEAREST WHOLE FOOT) FROM — TO

1: H-0 (18–9) — FROM 47 (11–15) — TO 272 (17–21)

2: (23–24) — (26–30) — (32–36)

3: (38–39) — (41–45) — (47–51)

SLOT SIZE 1. ____ 2. ____ 3. ____

DIAMETER OF SCREEN (56–60) (NEAREST INCH)

FROM ____ TO ____

GRAVEL PACK ____ ____

IF WELL DRILLED WAS A FLOWING WELL CIRCLE BOX (68) F

PUMPING TEST

C 3 (1–3) (SEQ. NO.) (6)

HOURS PUMPED (TO NEAREST HOUR) 3 (8–9)

PUMPING RATE (GALLONS PER MINUTE TO NEAREST GALLON) 12 (11–15)

METHOD USED TO MEASURE PUMPING RATE: WITCH & RUNOFF

WATER LEVEL: (DISTANCE FROM LAND SURFACE)

BEFORE PUMPING 115 (17–20) (NEAREST FOOT)

WHEN PUMPING 240 (22–25) (NEAREST FOOT)

TYPE OF PUMP USED (CIRCLE APPROPRIATE BOX) (FOR PUMPING TEST)

A AIR (27) — P PISTON (27) — T TURBINE (27)

C CENTRIFUGAL (27) — R ROTARY (27) — O OTHER (DESCRIBE BELOW) (27)

J JET (27) — S SUBMERSIBLE (27)

PUMP INSTALLED

TYPE OF PUMP (WRITE APPROPRIATE LETTER IN BOX – SEE ABOVE: A, C, J, P, R, S, T, O) (29)

DRILLER WILL INSTALL PUMP (CIRCLE APPROPRIATE BOX) — YES (Y) — NO (N)

CAPACITY: GALLONS PER MINUTE (TO NEAREST GALLON) (31–35)

PUMP HORSE POWER (37–41)

PUMP COLUMN LENGTH (NEAREST FOOT) (43–47)

CASING HEIGHT (CIRCLE APPROPRIATE BOX AND ENTER CASING HEIGHT)

+ ABOVE / – BELOW (49) — LAND SURFACE 1 (50–51) (NEAREST FOOT)

LOCATION OF WELL ON LOT

N ↑ SHOW PERMANENT STRUCTURE SUCH AS BUILDINGS, SEPTIC TANKS, AND/OR OTHER LAND MARKS AND INDICATE NOT LESS THAN TWO DISTANCES (MEASUREMENTS TO WELL).

PITLESS ADAPTER

CIRCLE APPROPRIATE BOXES

A A WELL WAS ABANDONED AND SEALED WHEN THIS WELL WAS COMPLETED

E ELECTRIC LOG OBTAINED

P TEST WELL CONVERTED TO PRODUCTION WELL

I HEREBY CERTIFY THAT I HAVE COMPLIED WITH ALL CONDITIONS STATED ON THE ABOVE-CAPTIONED "PERMIT TO DRILL WELL", AND THAT INFORMATION CONTAINED IN THIS REPORT IS TRUE, ACCURATE, AND COMPLETE TO THE BEST OF MY KNOWLEDGE, INFORMATION AND BELIEF.

DRILLERS NAME (PLEASE PRINT) M.J. Drilling Co.

SIGNATURE John D. Wells

WRA USE ONLY (NOT TO BE FILLED IN BY DRILLER)

T (70) TELESCOPE CASING — (E.R.O.S.) (72) LOG INDICATOR — LW Q (74 75 76) OTHER DATA AVAILABLE

HEALTH

I CERTIFY THE BELOW MEASUREMENTS AND ELEVATIONS ARE ACTUAL AND CORRECT FOR THIS PROPERTY

SIGNED: Julie E. Diehl

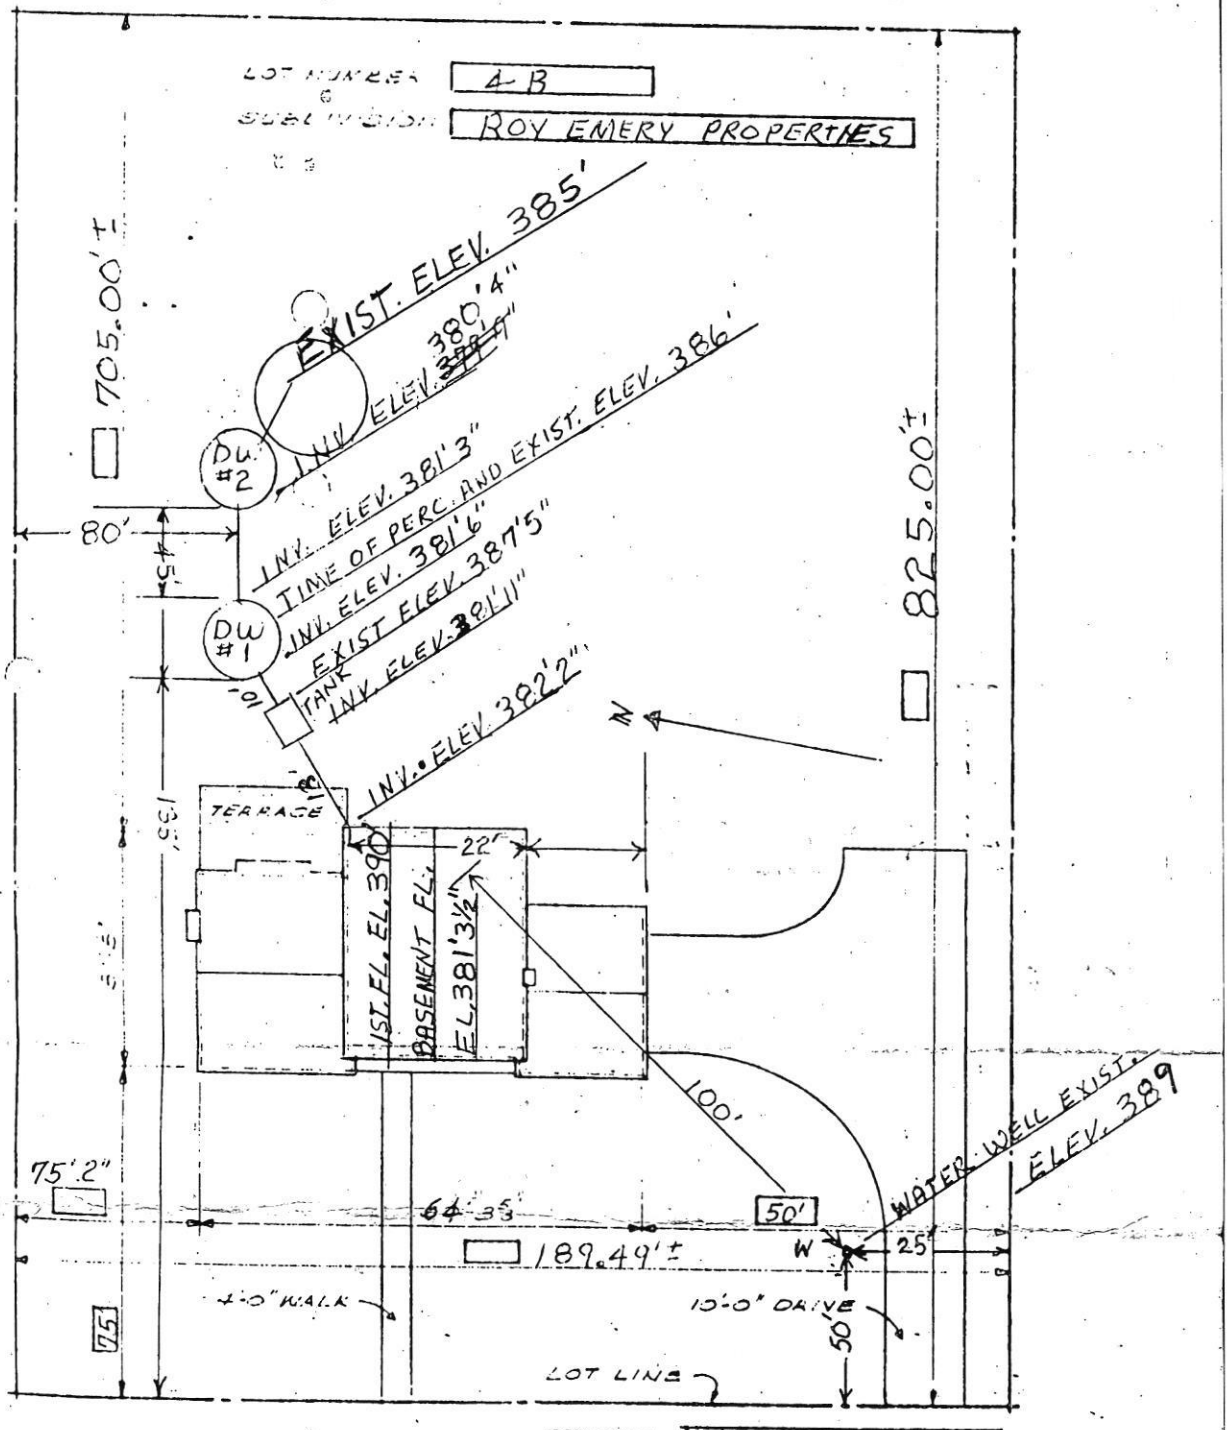

4/17/79 PLANS OK BUT WELL NOT YET GROUTED RH

PLOT PLAN

SCALE: 1"=20'-0"