

Menu Save Reset Cancel Help

Record Detail * (This section is required.)

Case

EH-PLANS-26-0

Type

EnvHealth/Environmental Health/Plan Check/Application

Status

In Review

Opened Date

07/09/2026

Single Entry Edit-View Record Form

Application Name

B26002303

Description

SFD/REPAIR TREE IMPACT DAMAGE TO EXISTING SFD INCLUDING REPLACEMENT OF DAMAGED ROOF DECKING, INSULATION, SHINGLES, ETC. - NO ADDITION OR FOOTPRINT EXPANSION (CB251250)**SUBJECT TO FIELD INSPECTION**

Total Invoiced

0.00

Total Paid

0.00

Balance

0.00

Assigned to Department Current Department

Well and Septic Program

Assigned to Staff Current User

Zack Silvast

Address * (This section is required.)

New Search Delete Set Primary

☐ Primary	<u>Street # (start)</u>	<u>Direction</u>	<u>Street Name</u>	<u>Street Type</u>	<u>City</u>	<u>State</u>	<u>Zip Code</u>	<u>Address Status</u>	<u>Street Suffix (Direction)</u>	<u>Unit Type</u>	<u>U</u>
☐ ☒	13813		Wayside	DR	Clar...	MD	21029				

Parcel (This section is not required.)

Search Delete Get Address & Owner Set Primary

☐ Primary	<u>Parcel #</u>	<u>Book</u>	<u>Page</u>	<u>Parcel</u>	<u>Parcel Area</u>	<u>Land Value</u>	<u>Improved Value</u>	<u>Exemption Value</u>	<u>Legal Description</u>	<u>Tract</u>
0 record(s) found.										

Owner (This section is not required.)

Search Delete Set Primary

Applicant * (This section is required.)

Search As Owner As Lic. Prof As Contact

Single Entry Applicant Form

Type *

Applicant

Primary

Yes

Full Name

First Name *

Courtney

Middle Name

Last Name *

Vail

Organization Name *

Clarksville Construction

Mobile Phone ((xxx)xxx-xxxx)

Online BP. 38 7/13/26

MPZ Approved
7/13/26

(443) 320-8801

Home Phone ((xxx)xxx-xxxx)

E-mail

courtney.v@clarksvilleconstruction.net

Business Phone ((xxx)xxx-xxxx)

Preferred Channel

--Select--

Applicant Address

New

Look Up

Deactivate

Remove

Custom Fields

DATE TRACKING

Received Date

7/8/2026

Dates to Complete

14

(Number)

Food Review Type

--Select--

Equipment Specification Sheet

Due Date

7/22/2026

Received by Food

Equipment Specification Sheets Submitted

Received by Community Hygiene

Received by Well and Septic

7/8/2026

FACILITY INFORMATION

Name of Business (dba) *

n/a (Text)

Associated Building Permit Number

(Text)

Owner Switch Date

Does the project include an Aquatic Facility such as a Public Pool? If Yes, forward to CH Program.

☐ Yes ☐ No

Does the project include Private Septic? If Yes, forward to WS Program.

☐ Yes ☐ No

Is this a Prototype Food Service Facility? If Yes, refer to State.

☐ Yes ☐ No

Facility Fax

(Text)

Days of Operation

(Text)

Does this project have a Building Permit?

☐ Yes ☐ No

Building Permit Issued Date

☐ Non-Profit

Does the project include Private Well? If Yes, forward to WS Program.

☐ Yes ☐ No

Does the project include Food Services? If Yes, forward to FP Program.

☐ Yes ☐ No

Facility Phone

(Text)

Facility Email

(Text)

PROPERTY INFORMATION

Water Source

--Select--

Design Wastewater Flow

(Number)

Sewage Disposal

--Select--

Permit Type

--Select--

DEVELOPMENT PLANS

Property Type

Residential

Signature Required

☐ Yes ☐ No

Number of paper copies

(Number)

Number of buildable lots created

(Number)

Total Number of Lots

0

(Number)

Plan Version

Initial

Engineer

(Text)

Number of mylar copies

(Number)

Number of non-buildable lots created

(Number)

Associated Plans

WELL AND SEPTIC INTERNAL

State Review Required

Coordinate State Review

☐ Yes ☐ No☐ Yes ☐ No

Proposed Septic System Type

--Select--

FOOD ESTABLISHMENT FACILITY

Priority Assessment

--Select--

Licensed Type

--Select--

License Category

--Select--

FOOD ESTABLISHMENT INFORMATION

Hours of Operation

(Text)

☐ Operating Seasonally Only

If Operating Seasonally. What is the start month?

(Text)

Are pets allowed in a outdoor seating area?

☐ Yes ☐ No

Full Bar?

☐ Yes ☐ No**RESTAURANT AND FOOD SERVICE**

Food Service Facility Secondary Category

--Select--

Total Seating Capacity

(Number)

Number of Restrooms

(Number)

Interior Restaurant Seating Capacity

(Number)

Bar Seating Capacity

(Text)

Outdoor Seating Capacity

(Text)

Does the restaurant have outdoor seating

☐ Yes ☐ No**EQUIPMENT**

Evaluated non NSF, ANSI, CF or other standards

☐ Yes ☐ No

Description of Refrigeration Units

Number of Walk-In Refrigerator Units

(Number)

Description of Walk-In Freezer Units

(Text)

Is there a bulk ice machine available

☐ Yes ☐ No

Space Limitation

Number of Hand Sinks Available

(Number)

Hood System

(Text)

Ventless Equipment

(Text)

PLUMBING

Size and installation of the water heater?

(Text)

Is there a grease interceptor or grease trap?

--Select--

REFUSE AND RECYCLABLES

Dumpsters Located on a impervious surface?

--Select--

Will there be a grease receptacle?

--Select--

WAREWASHING DISHWASHING

Dishwashing Method

--Select--

HACCP

Plan Review Response Letter Received

☐ Yes ☐ No

Date HACCP Approved by the State

☐

Date HACCP Plan Submitted

HACCP Plan Approved

☐

HACCP Plan Review

☐

Plan Review Letter Mailed

☐

HACCP Plan Revision Submitted

☐

HACCP Fee Type

--Select--

13813 WAYSIDE DRIVE
CLARKSVILLE, MD 21029

COVER SHEET

FLOOR PLAN

SECTION AND ELEVATION VIEWS

1. THE CONTRACTOR SHALL BE RESPONSIBLE FOR THE COORDINATION OF ALL TRADES AND SUB-CONTRACTORS REQUIRED FOR THE PROPER AND SAFE COMPLETION OF THE PROJECT.

- [illegible]

THE REPAIRED PORTIONS OF THE STRUCTURE HAVE BEEN DESIGNED TO CONFORM WITH APPLICABLE PROVISIONS OF THE 2024 INTERNATIONAL RESIDENTIAL CODE (IRC) AND 2024 INTERNATIONAL COSTING BUILDING CODE (CBC) WITH LOCAL AMENDMENTS FROM HOBART COUNTY. MINIMUM UNIFORMLY DISTRIBUTED LINE LOADS PER IRC R301.5.

- [illegible]

ALL WOODS AND WOOD CONSTRUCTION SHALL COMPLY WITH SPECIFICATIONS AND CODES MODIFICATIONS AS SPECIFIED HEREIN.

- [illegible]

3. ALL PLATES, ANCHORS, NAILS, BOLTS, NUTS, WASHERS, AND OTHER MISCELLANEOUS HARDWARE SHALL BE HOT DIP GALVANIZED.


[illegible][illegible][illegible][illegible]




[illegible]





BANDERA RESIDENCE
TREE IMPACT DAMAGE REPAIR
13913 WAYSIDE DRIVE
CLARKSVILLE, MD 21029

OWNER/CLIENT:
CLARKSVILLE CONSTRUCTION
SERVICES
2360 COCA COLA DR SUITE 172

SUBMISSIONS / REVISIONS		
S.N.	DESCRIPTION	DATE
1	CODES PRG/NUM DOCS	30/07/98



COVER SHEET

DATE	5/5/28
REC'D BY	7260-071
REASON BY	R. SMITH
RECEIVED BY	R. SMITH

0001




P.O. BOX 100, ELICOTT CITY, MD 21041
(410) 581-4331 • www.tiber.com

BANDERA RESIDENCE
TREE IMPACT DAMAGE REPAIR
13813 WAYSIDE DRIVE
CLARKSVILLE, MD 21029

OWNER (CLIENT)
CLARKSVILLE CONSTRUCTION
7380 CORD ROAD SW SUITE 113
HARRISBURG, MD 21756


NO.	DESCRIPTION	DATE
01	CONSTRUCTION	06/24/14
02	ELEVATION #	01/01/14

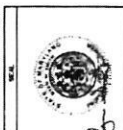


SECTION &
ELEVATION
VIEWS

DATE	01/01/14
PROJECT #	1000-001
DRAWN BY	E. Smith
REVIEWED BY	E. Smith


SHEET NO.
0003

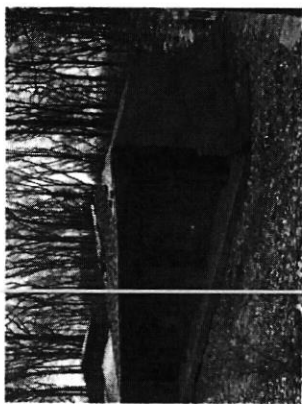

FRONT ELEVATION VIEW

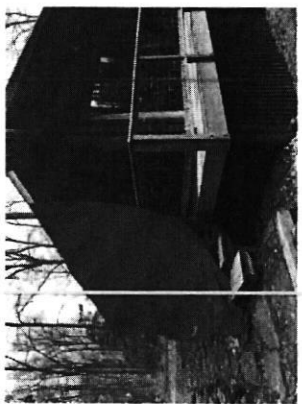


RIGHT ELEVATION VIEW

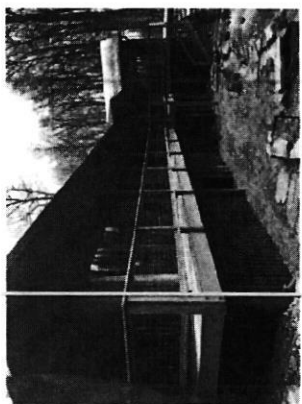


REAR ELEVATION VIEW

1. PHOTOGRAPHY: PHOTOGRAPHS WERE TAKEN FROM THE FRONT, RIGHT, AND REAR ELEVATIONS OF THE STRUCTURE. 

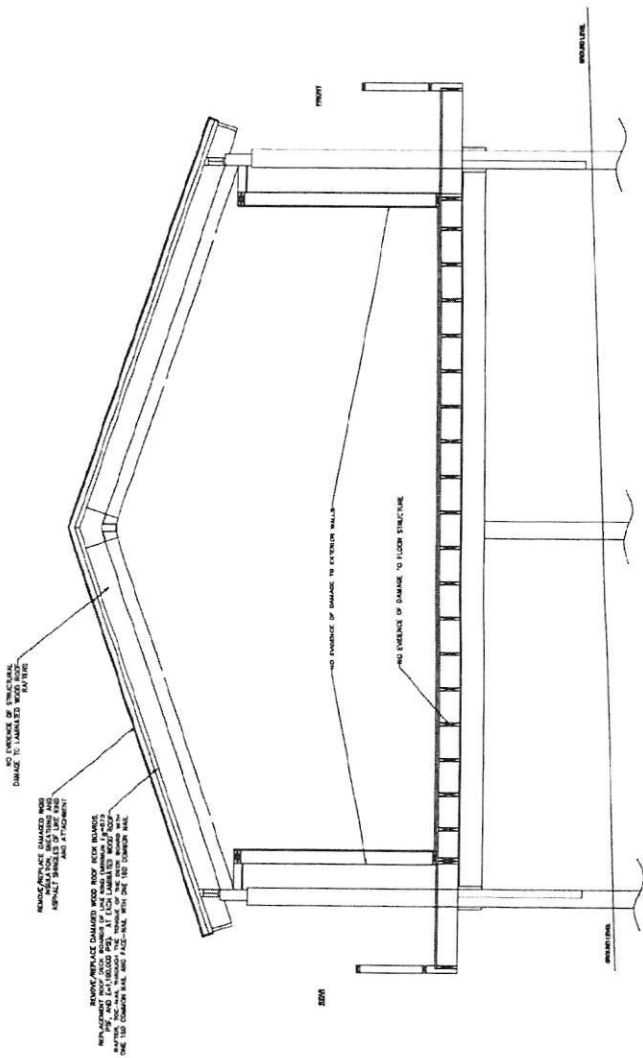

SECTION
A-A
SCALE: 1/8" = 1'

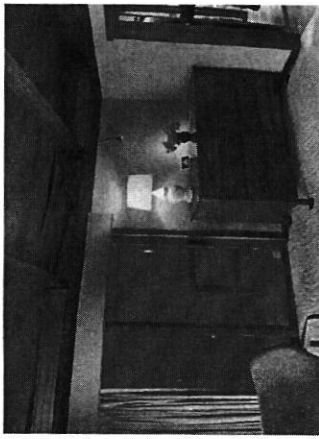

INTERIOR ELEVATION VIEW OF DAMAGED AREA