5-7-86 ASAP AM

5-7-86 approved S. Hoof

TAX# 03296884

PERMIT

P 37012

A REPAIR

SEWAGE DISPOSAL SYSTEM

MARYLAND STATE DEPARTMENT OF HEALTH*

HOWARD COUNTY
BUREAU OF ENVIRONMENTAL HEALTH
~~992-2330~~ 461-9933

INDEXED

ELLICOTT CITY
DISTRICT 3rd

DATE 5/6/86

Jack Fyock IS PERMITTED TO INSTALL ____ ALTER X

ADDRESS 13775 Triadelphia Road, Glenelg, Md. 21737 PHONE 988-9270

SUBDIVISION Woodmark ROAD 12206 Carroll Mill Road LOT 57, Blk. E, Sec. 3

PROPERTY OWNER Richard Nicola

ADDRESS 12206 Carroll Mill Road, Ellicott City, Md. 21043 Phone: 531-3059

IF GARBAGE GRINDER IS USED INCREASE SEPTIC TANK CAPACITY BY 50% AND ABSORPTION AREA BY 22%.

GARBAGE GRINDER? YES ____ NO ____

SEPTIC TANK CAPACITY ____ GALLONS NUMBER OF BEDROOMS ____

REPAIR - Call for an appointment when ground is opened up and Sanitarian will recommend the repair system.

PLANS APPROVED BY Craig Williams DATE 5/6/86

COVER NO WORK UNTIL INSPECTED AND APPROVED.

NEITHER THE HOWARD COUNTY COUNCIL NOR THE HEALTH DEPARTMENT IS RESPONSIBLE FOR THE SUCCESSFUL OPERATION OF ANY SYSTEM.

NOTE: IF TRENCH IS USED CALL FOR INSPECTION BEFORE AND AFTER PLACING GRAVEL IN TRENCH.

NOTE: NO DRY WELL SHALL EXCEED 15 FOOT IN DIAMETER. NO ABSORPTION TRENCH TO EXCEED 100 FEET IN LENGTH.

NOTE: ALL PIPE FROM HOUSE TO SEPTIC TANK MUST BE CAST IRON OR SCHEDULE 40 PVC OR ABS.

PERMIT VOID AFTER THREE YEARS.


NOTE: INSTALL STAND PIPE ON SEPTIC TANK AND DRY WELL. STAND PIPES MUST BE 6 INCHES IN DIAMETER. CAST IRON, CONCRETE OR TERRA COTTA, OR PVC OR ABS ACCEPTED. IF TOP OF SEPTIC TANK IS DEEPER THAN 3 FEET MANHOLE TO GRADE REQUIRED.

***INSTALLER IS RESPONSIBLE FOR OBTAINING FINAL APROVAL ON THIS PERMIT**

*CALL ~~992-2330~~ FOR INSPECTION OF SEPTIC SYSTEMS.

EH - 2-1082

37012 A REPAIR

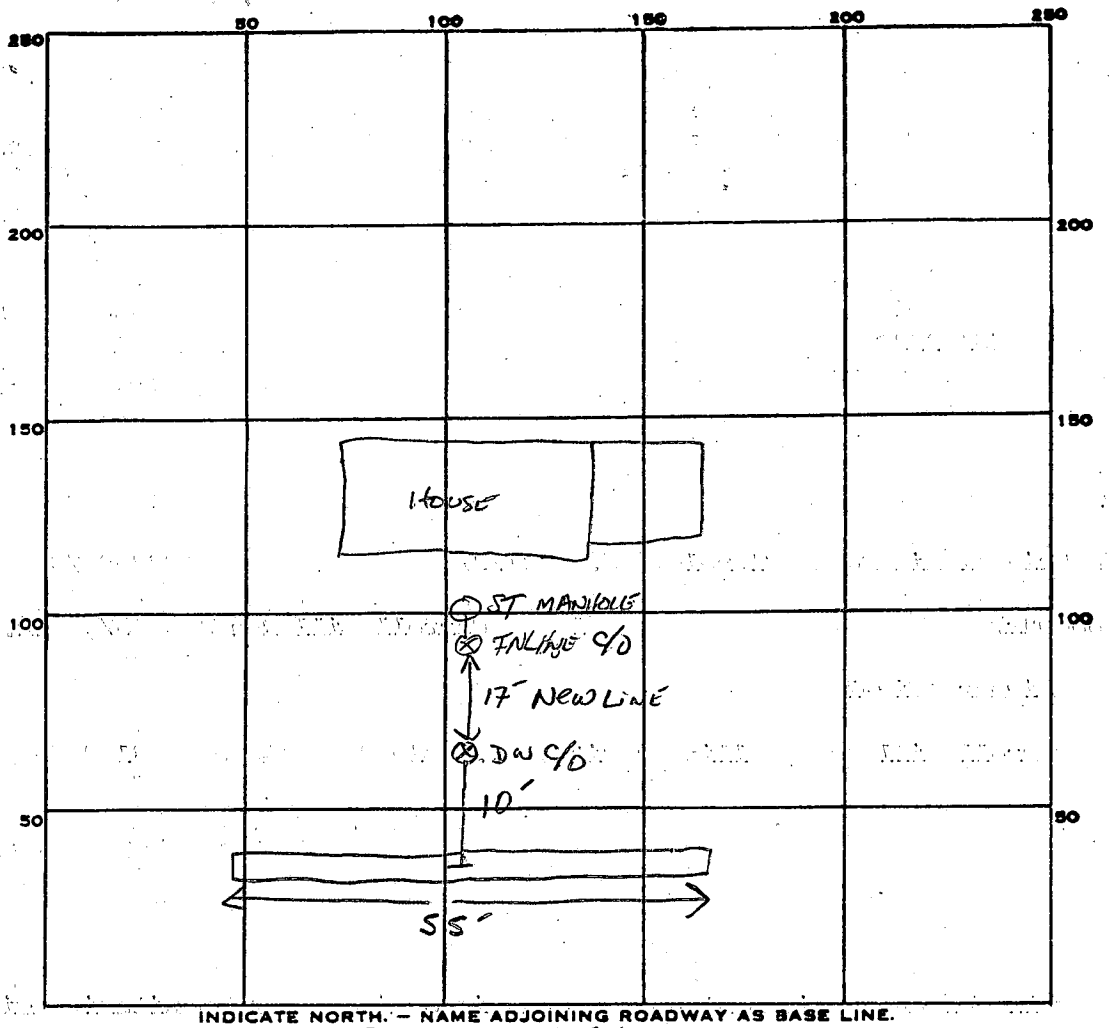

INDICATE NORTH. — NAME ADJOINING ROADWAY AS BASE LINE.

CARROLL Mill Rd.

PERMIT CARD ✓

SEPTIC TANK, LEVEL EXISTING CLEANOUTS EXISTING ST + DW

DISTRIBUTION BOX, LEVEL N/A

TILE FIELD, DEPTH 10 FT. TRENCH WIDTH 2 FT. INLET 3'

GRAVEL DEPTH 7 Ft IN. TOTAL LENGTH 55 FT.

NUMBER OF TRENCHES 1 ONE SIDE WALL ~~TOTAL BOTTOM~~ AREA 385 Ø

SEEPAGE PITS, INSIDE DIAMETER — FT. DEPTH BELOW INLET — FT.

ABSORBENT AREA 385 SQ. FT.

REMARKS 5-7-86 - OK TO ADD STONE TO TRENCH. S. Abel

DATE SYSTEM APPROVED 5-7-86 INSPECTOR S. Abel

7/21/70 appraised $to

PERMIT

P 15368

A 13074

SEWAGE DISPOSAL SYSTEM

MARYLAND STATE DEPARTMENT OF HEALTH

HOWARD COUNTY

ELLICOTT CITY

DISTRICT 5

INDEXED

DATE 7/13/70

Robert Dubin Co. IS PERMITTED TO INSTALL X ALTER

ADDRESS Rt. 2, Clarksville, Md. PHONE 286-3432

A SEWAGE DISPOSAL-SYSTEM LOCATED AT

SUBDIVISION Woodmark, Inc. ROAD Carroll Mill LOT 57, Blk. E, Sec/ 3

PROPERTY OWNER Woodmark, Inc.

ADDRESS

SPECIFICATIONS - 3 bedrooms

DRAIN FIELD _____ DEPTH _____ FEET, BOTTOM AREA _____ SQ. FT.

SEEPAGE PITS _____ ABSORBENT SIDE-WALL AREA _____ SQ. FT.

SEPTIC TANK CAPACITY 750 GALLONS

FOR GARBAGE GRINDER, INCREASE DISPOSAL AREA 22% & TANK CAPACITY 50%.

OTHER Dry well - 100 sq. ft. absorbent sidewall area per bedroom below inlet pipe. Max. depth permitted for dry well below original grade is 11 ft. Place dry well 33 ft. from front lot line and 67 ft. from left side line as seen when facing from Carroll Mill Road.

PERMIT VOID AFTER THREE YEARS.

NOTE: ALL PIPE FROM HOUSE TO TANK MUST BE CAST IRON.


PLANS APPROVED BY D. W. Monaghan DATE 10/14/68

FILL SEPTIC TANK AND DISTRIBUTION BOX WITH WATER BEFORE CALLING FOR AN INSPECTION. COVER NO WORK UNTIL INSPECTED AND APPROVED.

NEITHER THE HOWARD COUNTY COMMISSIONERS NOR THE HEALTH DEPARTMENT IS RESPONSIBLE FOR THE SUCCESSFUL OPERATION OF ANY SYSTEM.

A 130 74

Lot 57, Blk. E, Sec. 3

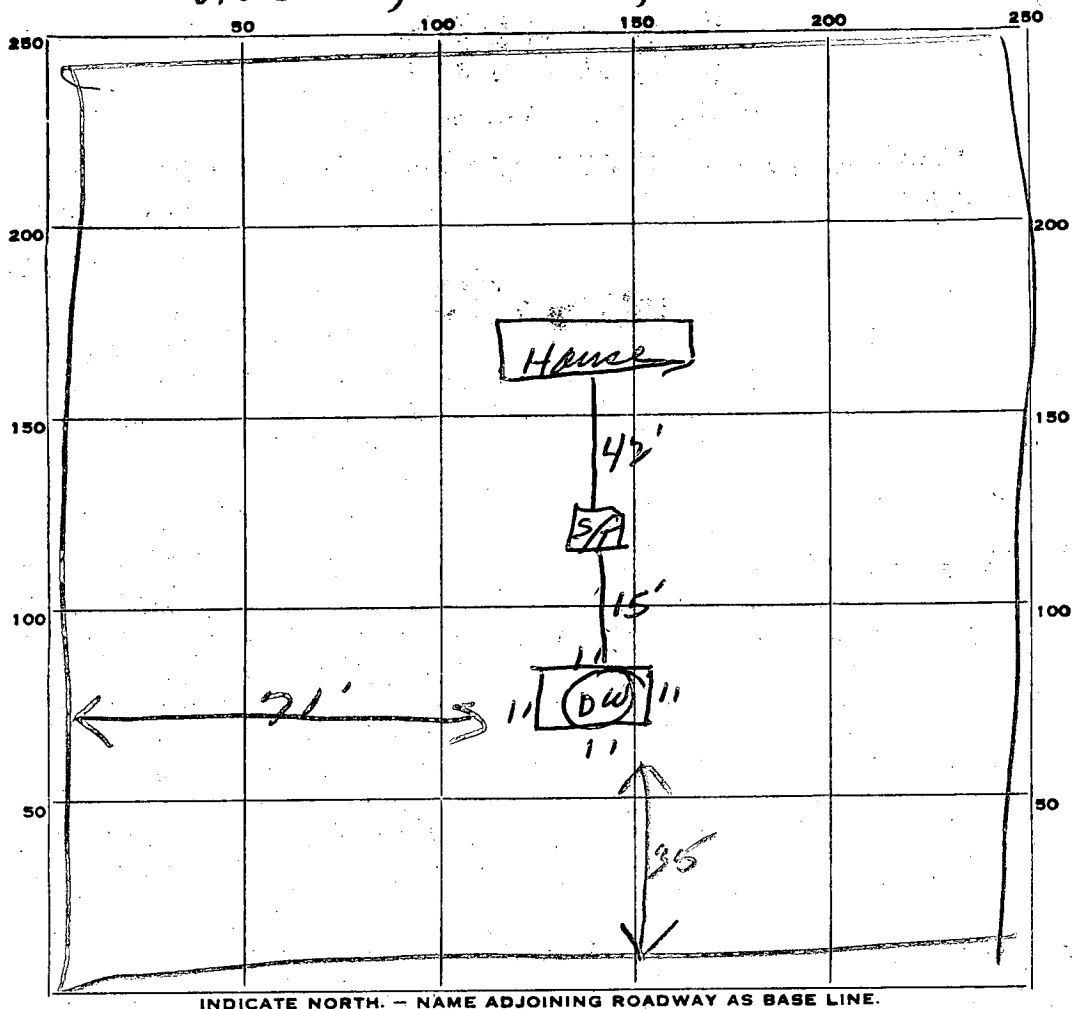

INDICATE NORTH. — NAME ADJOINING ROADWAY AS BASE LINE.

Carrill Rd

PERMIT CARD OK

SEPTIC TANK, LEVEL Cemet 1000 CLEANOUTS OK

DISTRIBUTION BOX, LEVEL

TILE FIELD, DEPTH ____ FT. TRENCH WIDTH ____ FT.

GRAVEL DEPTH ____ IN. TOTAL LENGTH ____ FT.

11 X 11 NUMBER OF TRENCHES ____ TOTAL BOTTOM AREA ____

SEEPAGE PITS, INSIDE DIAMETER 7 FT. DEPTH BELOW INLET 8 1/2 FT.

ABSORBENT AREA 374 SQ. FT.

REMARKS

DATE SYSTEM APPROVED 7/21/70 INSPECTOR

APPLICATION

A 13074

P

SEWAGE DISPOSAL TESTING

MARYLAND STATE DEPARTMENT OF HEALTH

HOWARD COUNTY

ELLICOTT CITY

DISTRICT 3

DATE 9/6/67

Septic Tank - 3 bedroom - 750 gal
4 " - 1000 gal.

Dry Well - 100 sq ft of absorbent sidewall and ~~to be~~ per bedroom below inlet pipe. Max depth permitted for Dry Well below original grade is 14ft.

Place Dry Well 33 ft from front lot line and 67 ft from left sideline as seen when facing from Carroll Mill Rd.

TO: THE COUNTY HEALTH OFFICER
ELLICOTT CITY, MARYLAND

I, HEREBY, APPLY FOR THE NECESSARY TESTS IN ORDER TO CONSTRUCT (OR RECONSTRUCT) A SEWAGE DISPOSAL SYSTEM.

PROPERTY OWNER Woodmark, Inc. - M. A. Wakefield

ADDRESS 231 Chatham Rd., Ellicott City, Md. PHONE

PROPERTY LOCATION:

SUBDIVISION Woodmark, Inc. LOT NO. 57, Blk. E, Sec. 3

ROAD AND DESCRIPTION Carroll Mill Rd.

OCCUPANT PHONE

PERSON TO CONSTRUCT SYSTEM

ADDRESS PHONE

SIZE OF LOT 150' x 270' x 60' x 140' x 260' TYPE BLDG. 3 or 4 (NUMBER OF BEDROOMS)

IF NOT SINGLE RESIDENCE DESCRIBE

SIGNATURE OF APPLICANT /s/ M. A. Wakefield


APPROVED BY Geo Monaghan FOR Dry Well (KIND OF SYSTEM) DATE 10-14-67

REJECTED BY FOR (KIND OF SYSTEM) DATE

HOLD PENDING FURTHER TESTS DATE

REASONS FOR REJECTION OR HOLDING

THIS IS NOT A PERMIT

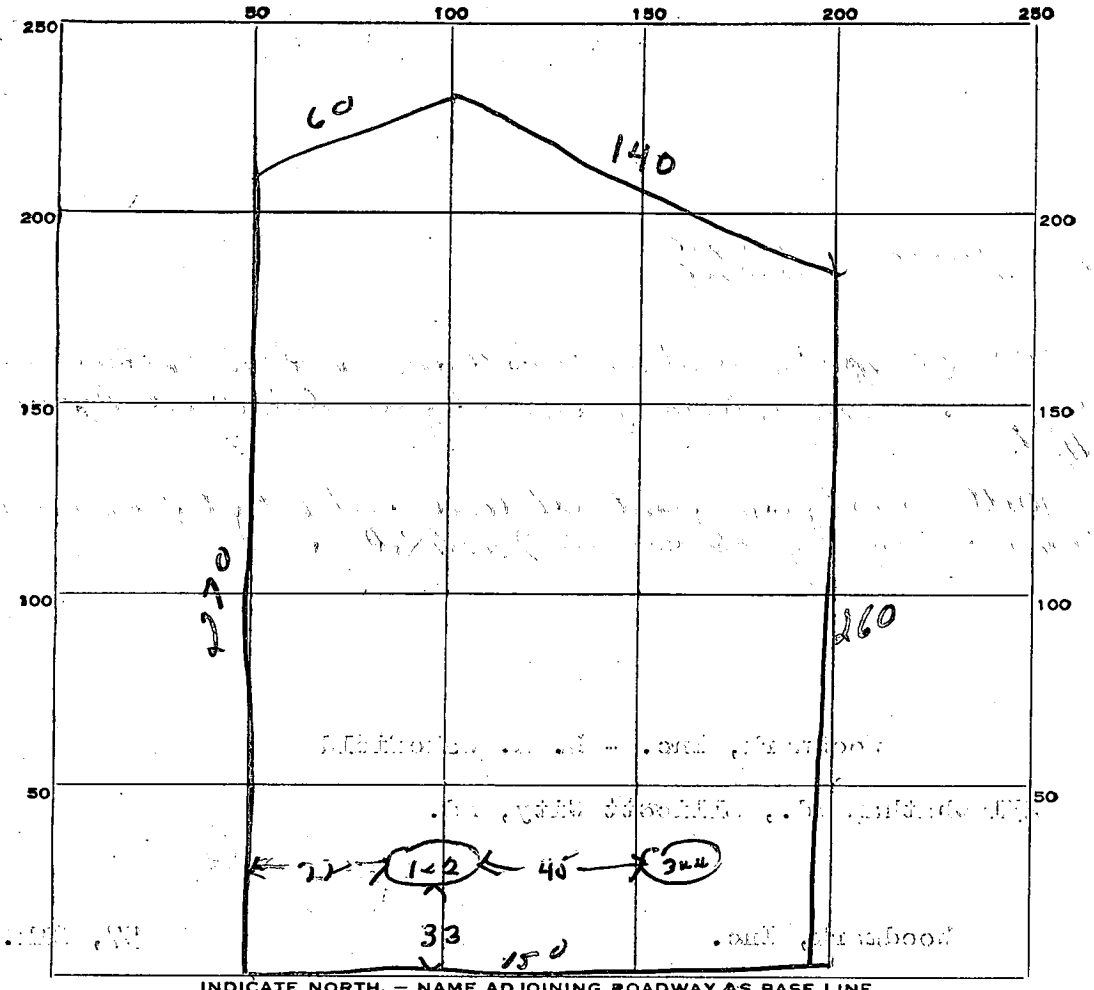

INDICATE NORTH. — NAME ADJOINING ROADWAY AS BASE LINE.

Carroll Mill Rd

DATE	TEST NO.	DEPTH	PRE-WET START	PRE-WET STOP	TEST - 1" DROP START	TEST - 1" DROP STOP	TIME
9/7/67	1	4ft	10 58	over time			
	2	10 1/2 ft	10 58	11 07	11 07	11 27	20 min
	3	10 1/2 ft	10 59	11 01	11 01	11 10	9 min
	4	4 1/2 ft	11 00	11 02	11 02	11 05	3 min

SOIL AUGER FINDING

TESTED BY Lewm

REMARKS Wide shallow DW (use pit (3rd) for original system

57 E7

Preliminary

APPLICATION

SEWAGE DISPOSAL TESTING

MARYLAND STATE DEPARTMENT OF HEALTH

A 13074

P

HOWARD COUNTY

ELLICOTT CITY

DISTRICT 3

DATE 9/6/67

TO: THE COUNTY HEALTH OFFICER
ELLICOTT CITY, MARYLAND

I, HEREBY, APPLY FOR THE NECESSARY TESTS IN ORDER TO CONSTRUCT (OR RECONSTRUCT) A SEWAGE DISPOSAL SYSTEM.

PROPERTY OWNER Woodmark, Inc. - M. A. Wakefield

ADDRESS 231 Chatham Rd., Ellicott City, Md. PHONE

PROPERTY LOCATION:

SUBDIVISION Woodmark, Inc. LOT NO. 57, Blk. E, Sec. 3

ROAD AND DESCRIPTION Carroll Mill Rd.

OCCUPANT PHONE

PERSON TO CONSTRUCT SYSTEM

ADDRESS PHONE

SIZE OF LOT 150' x 270' x 60' x 140' x 260' TYPE BLDG. 3 or 4 (NUMBER OF BEDROOMS)

IF NOT SINGLE RESIDENCE DESCRIBE

SIGNATURE OF APPLICANT /s/ M. A. Wakefield


APPROVED BY Wm. Monaghan FOR Dry Well (KIND OF SYSTEM) DATE 10-14-68

REJECTED BY FOR (KIND OF SYSTEM) DATE

HOLD PENDING FURTHER TESTS DATE

REASONS FOR REJECTION OR HOLDING

THIS IS NOT A PERMIT

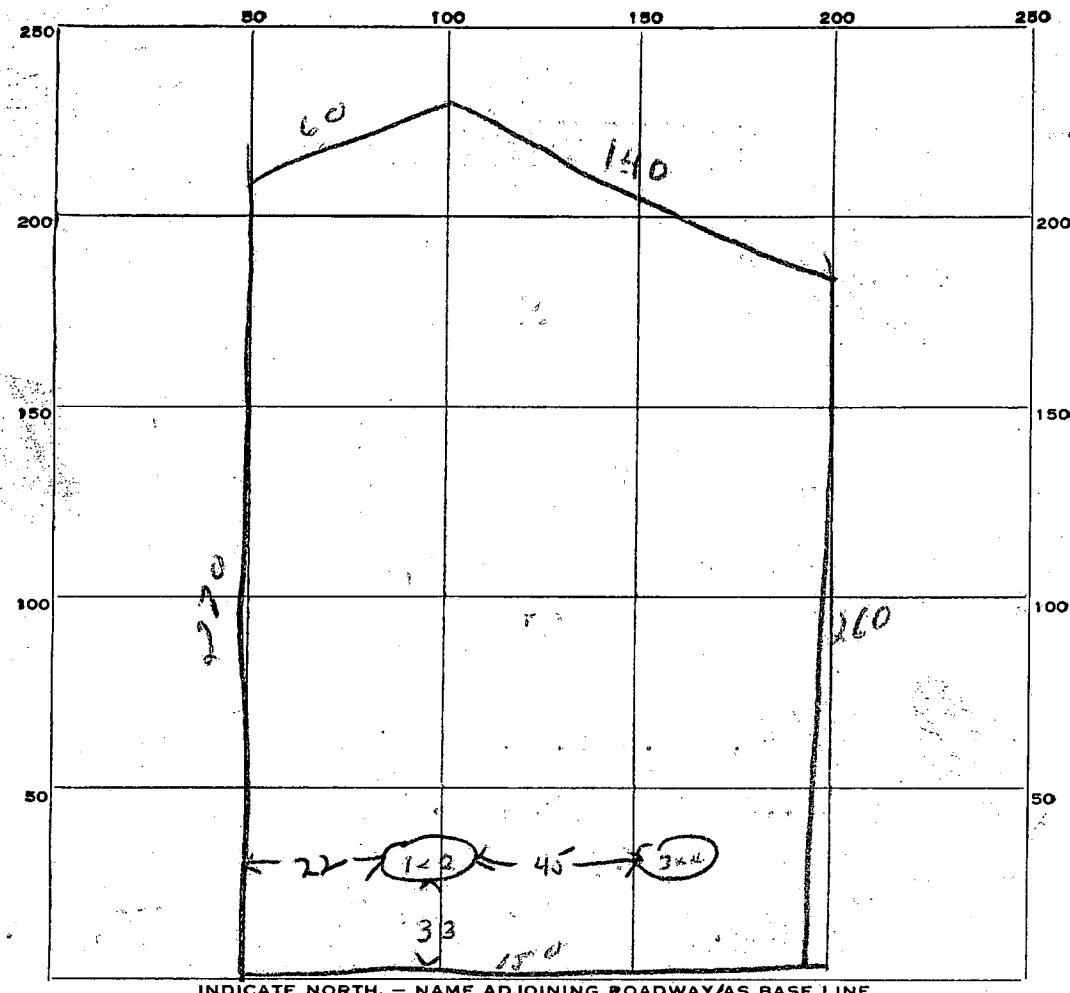

INDICATE NORTH. — NAME ADJOINING ROADWAY AS BASE LINE.

Carroll Mill Rd


DATE	TEST NO.	DEPTH	PRE-WET START	PRE-WET STOP	TEST - 1" DROP START	TEST - 1" DROP STOP	TIME
9/1/67	1	4ft	10 58	overtime			
	2	10ft	10 58	11 07	11 07	11 27	20 min
	3	10 1/2 ft	10 59	11 01	11 01	11 10	9 min
	4	4 1/2 ft	11 00	11 02	11 02	11 05	3 min

SOIL AUGER FINDING _____

TESTED BY Dunn

REMARKS With shallow Dill (use perk (3rd) for original system

57 Em

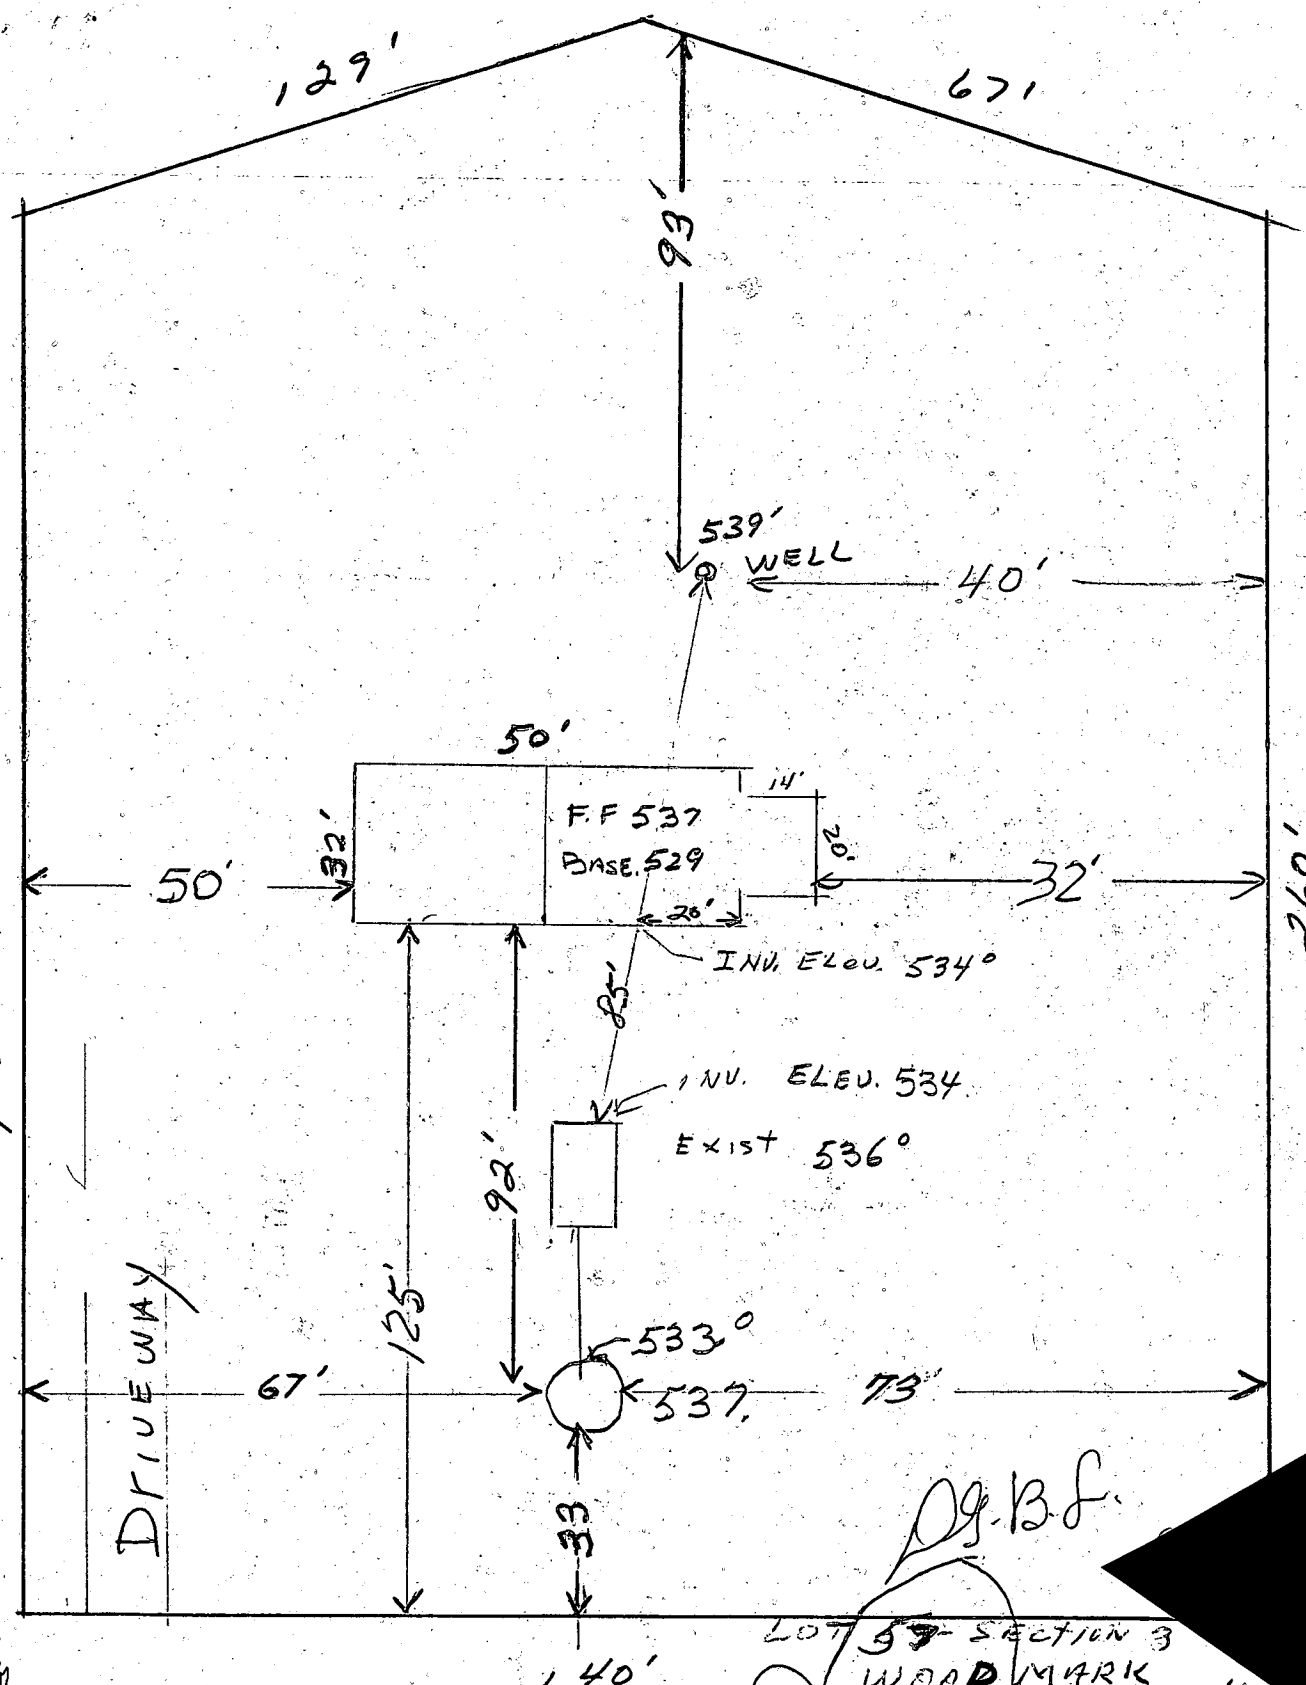
129'
67'
93'
539'
WELL
40'
50'
14'
F.F 537
BASE. 529
20'
32'
50'
32'
210'
20'
INV. ELEV. 534°
85'
INV. ELEV. 534
EXIST 536°
92'
100'
DRIVEWAY
125'
533°
537
67'
73'
33'
140'
LOT 57 - SECTION 3
WOODMARK
CARROLL MILL
Woodmark Lot 57 Section 3

WR-W-3 3-69

No. 2518

B 1 8215 — SEQUENCE NO. (DWR USE ONLY)
1 2 3 (SEQ. NO.) 6
(THIS NUMBER IS TO BE PUNCHED IN COLS. 3-6 ON ALL CARDS)

STATE OF MARYLAND
DEPARTMENT OF WATER RESOURCES
STATE OFFICE BLDG., ANNAPOLIS, MARYLAND 21401
APPLICATION FOR PERMIT TO DRILL WELL

APPLICATION MUST BE SUBMITTED AND PERMIT RECEIVED BEFORE DRILLING IS STARTED.
FILL IN THIS FORM COMPLETELY

DATE RECEIVED (DWR USE ONLY) 8/21/70 10 AM 2nd
8-13

OWNER Blake G. Daniel Jr.
COL 15 LAST NAME — FIRST NAME COL 34
STREET OR RFD 432 South Carolina Ave. HO-71-0004
COL 36 COL 55
POST OFFICE Pasadena, Maryland
COL 57 COL 80

B 2 — DRILLER INFORMATION
1 2 3 (SEQ. NO.) 6
G. Edgar Harr Sons' Corp — IDENTITY NUMBER 122
8 FIRST NAME DRILLER LAST NAME 27 29 32
Falls Road Phone 252 4588
34 STREET OR RFD 53
Cockeysville, Md. 21030
55 POST OFFICE ZIP CODE 80
DATE OF APPLICATION 6-23-70

B 3 — WELL INFORMATION
1 2 3 (SEQ. NO.) 6
MAXIMUM PUMPING RATE (GALLONS PER MINUTE) 5 (8 12)
AVERAGE DAILY QUANTITY NEEDED (GALLONS PER DAY) 500 (14 20)

USE FOR WATER (CIRCLE APPROPRIATE BOX)
(D) DOMESTIC, HOME (SINGLE OR DOUBLE HOUSEHOLD UNIT ONLY)
F FARMING, AGRICULTURE, IRRIGATION
I INDUSTRIAL, COMMERCIAL, STATE AND FEDERAL GOVERNMENT.
22
M MUNICIPAL WATER SUPPLY
P PRIVATE WATER COMPANY
} MUST HAVE STATE HEALTH DEPT. APPROVAL
T TEST

APPROXIMATE DEPTH OF WELL 150 FEET (24 28)

METHOD OF DRILLING USED (CIRCLE APPROPRIATE METHOD)
BORED (OR AUGERED) JETTED DRIVEN
30-37 AIR-ROTARY (AIR-PERCUSSION) ROTARY (HYDRAULIC ROTARY)
CABLE REVERSE ROTARY
OTHER (DESCRIBE)


REPLACEMENT OR DEEPENED WELLS (CIRCLE APPROPRIATE BOX)
(N) THIS WELL WILL NOT REPLACE AN EXISTING WELL
39 Y THIS WELL WILL REPLACE A WELL THAT WILL BE ABANDONED AND SEALED
S THIS WELL WILL REPLACE A WELL THAT WILL BE USED AS A STANDBY
D THIS WELL WILL DEEPEN AN EXISTING WELL
PERMIT NUMBER OF WELL TO BE REPLACED OR DEEPENED (IF AVAILABLE)
(41 52)

NOT TO BE FILLED IN BY DRILLER (DWR USE ONLY)
APPROPRIATION PERMIT NUMBER GAP (54 63)
ENGINEER REVIEW (WRITE DISTRICT NO. IN BOX) (65)
FORCE (67 68) WRITE INITIALS IN BOX
CONDITIONS A E N S G W Q (70 71 72 73 74 75 76 77 78 79)

B 4 — LOCATION OF WELL
1 2 3 (SEQ. NO.) 6
COUNTY Howard (8 — DO NOT ABBREVIATE COUNTY NAME — 21)
SUBDIVISION Woodmark Dev. (23 42)
SECTION Blk E (44 46) LOT 57 (48 50)
NEAREST TOWN Ellicott City (52 71)
MILES FROM TOWN (ENTER 0 IF IN TOWN) 5 (73 76 77 78) M I

B 5 — DIRECTION FROM TOWN (CIRCLE APPROPRIATE BOX)
1 2 3 (SEQ. NO.) 6
N NORTH E EAST NE NORTHEAST SE SOUTHEAST
S SOUTH (W) WEST NW NORTHWEST SW SOUTHWEST
8 8 8 9 8 9
NEAR WHAT ROAD Carroll Mill Road (11 30)
ON WHICH SIDE OF ROAD (CIRCLE APPROPRIATE BOX) NORTH (N) SOUTH (S) EAST (E) WEST (W) (32 32 32 32)
DISTANCE FROM ROAD (ENTER DISTANCE AND CIRCLE APPROPRIATE BOX) 80 (34 37) F T M I (38 39)

DRAW A SKETCH BELOW SHOWING LOCATION OF WELL IN RELATION TO NEARBY TOWNS, ROADS AND STREAMS WITH NORTH IN THE DIRECTION OF THE ARROW, AND GIVE DISTANCE FROM WELL TO NEAREST ROAD JUNCTION OR STREAM CROSSING SHOWN ON THE SKETCH. DISTANCE MAY BE APPROXIMATE, BUT MUST BE INDICATED.

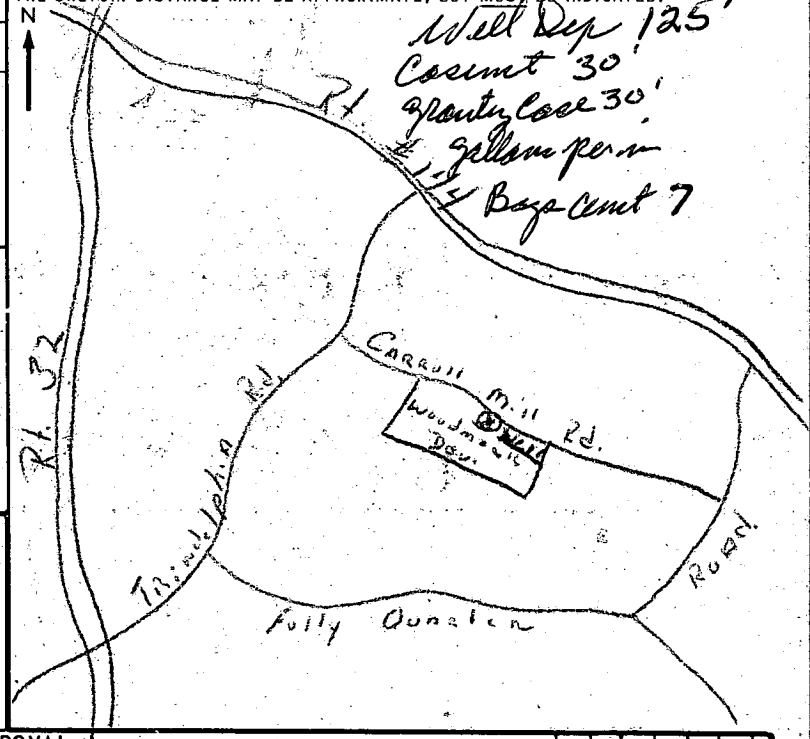

B 5 CONTINUED
1 2 3 (SEQ. NO.) 6
41 S STATE DEPARTMENT OF HEALTH (CIRCLE BOX IF STATE HEALTH)
DATE MO. 6 DAY 25 YR. 70 (43 48)

HEALTH DEPARTMENT APPROVAL (NOT TO BE FILLED IN BY DRILLER)
Howard COUNTY DEPT. OF HEALTH
APPROVED BY Peter F. Wise TITLE Director Environmental Health
A 13474

LATITUDE 39 16 30 (50 51 52 53 54 55) DEG MIN SEC
LONGITUDE 076 56 23 (57 58 59 60 61 62 63) DEG MIN SEC
ELEVATION AT WELL HEAD (FEET) 0420 (65 66 67 68)

B 6 — SPECIAL CONDITIONS 8-63 (DWR USE ONLY)
1 2 3 (SEQ. NO.) 6
(8 63)

HEALTH